

CERTIFIED RECORD OF LAND CORNER MONUMENTATION

C-1


History of original corner establishment:

W.B. Barr conducted the survey of the exterior lines of Township 7 South, Range 43 East, W.M., Contract No. 388, dated May 17, 1881.

For the corner point Barr set a stake 4 ft. long 4 ins. dia. 11 ins. into the ground for $\frac{1}{4}$ sec. corner from which:

A Pine 15 ins. dia., bears S. $11\frac{1}{2}^{\circ}$ W. at 53 lks. dist.

A Pine 18 ins. dia., bears S. 89° E. at 79 lks. dist.

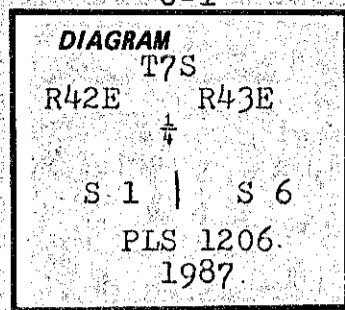

Description of corner evidence found:

Found a live 26" dia. Ponderosa Pine bearing S. $11\frac{1}{2}^{\circ}$ W. at 35.0 ft. dist. mkd: Blaze is healed over with no scribe visible.

Description of monument and accessories I established to perpetuate the original location of this corner:

Set a $2\frac{1}{2}$ " x 30" alum. pipe with a $2\frac{1}{2}$ " alum. cap set 24" into the ground. Constructed a 36" dia. stone mound around the monument. Cap is marked as shown in the corner diagram. Reestablished original corner from bearing and distance from found bearing tree.

From the corner point: (New BT)

A 10" dia. Western Larch bears N. 53° E. at 28.8 ft. dist., mkd. $\frac{1}{4}$ S 6 BT.


Set a steel fence post 4 ft. South from the monument and attached a USFS 54-9 sign. Painted the face of the blaze and a 6 in. band around the bearing trees red. I.D. washer was nailed between the scribed B and T of the new bearing tree. The washer is $\frac{3}{4}$ " in diameter and made of brass with PLS 1206 stamped on one side. Attached USFS 54-9 and 54-3 signs to bearing trees. Used $18\frac{1}{2}^{\circ}$ declination on a staff compass for readings to bearing trees. Used a steel tape to measure to a nail set in the side of the tree.

This corner was monumented to USFS specifications on August 6, 1987, witnessed by Tom Fisk and Andy Marlette.

Office of Co. Surveyor County of Baker
 State of OR I hereby certify that the within instrument was filed in this office
 for record on the day of 19.....

(COUNTY OFFICIAL)

by (DEPUTY)

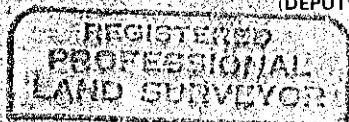

Form R6-7100-57 (9/71)

☆ GPO-798-276

FILED 10/18/88
 BAKER COUNTY SURVEYOR
 SURVEY NO. 7-43-142
7-42-7