


CERTIFIED RECORD OF LAND CORNER MONUMENTATION

C-5

History of original corner establishment:

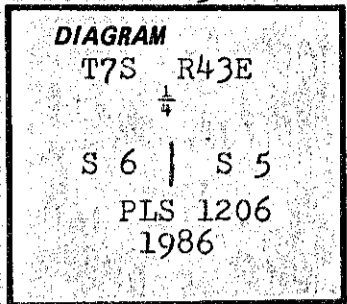

W.B. Barr conducted the survey of Township 7 South, Range 43 East, W.M., August 29 to September 8, 1881, under GLO Contract No. 388, dated May 7, 1881. The original notes of that survey relative to this corner state the following:

- Marked a basalt rock 16" x 14" x 8" for ¼ sec. corner, from which:
- A Pine, 6 ins. dia., bears N. 69° E., at 64 lks. dist.
- A Pine, 5 ins. dia., bears N. 81° W., at 26 lks. dist.

Description of corner evidence found:

Found a basalt stone, 15" x 12" x 8" with a faint ¼ on the face. The stone was found in an old stone mound, lying face down.

Old bearing trees:

- A Ponderosa Pine, 14 ins. dia., bears N. 69° E., at 42.2 ft. dist., mkd. healed blaze.
  - A Ponderosa Pine, 17 ins. dia., bears N. 81° W., at 17.2 ft. dist., mkd. healed blaze.
- These original bearing trees were in good shape at the time of remonumentation.

Description of monument and accessories established to perpetuate the original location of this corner:


At the position of recovered stone a 2½" x 30" aluminum pipe with a 2½" aluminum cap was set 18 ins. into the ground. Constructed a 36 in. dia. stone mound around the monument. The cap is marked as shown in the corner diagram. Buried the original corner stone 1 ft. to the North of the monument.

Set a steel fence post 4 ft. North of the corner and attached a 54-9 USFS sign. Painted the healed blaze and a 6 in. band around the bearing trees red. Attached USFS 54-9 and 54-3 signs to the bearing trees. Used 18½° declination on a staff compass for readings to bearing trees. Used a steel tape to measure to a nail set in the side of the trees.

This corner was remonumented to USFS specifications on December 10, 1986, witnessed by Tom Fisk and Larry McBroom.

Office of County Surveyor County of Baker  
State of OR I hereby certify that the within instrument was filed in this office for record on the ..... day of ..... 19.....

(COUNTY OFFICIAL)

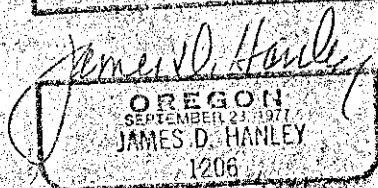

Form R6-7100-57 (9/71)

☆ GPO—798.276

FILED 10/18/88  
BAKER COUNTY SURVEYOR  
SURVEY NO. 7-43-1/3