

CERTIFIED RECORD OF LAND CORNER MONUMENTATION


E-7

History of original corner establishment:

W.B. Barr conducted the survey of Township 7 South, Range 43 East, W.M., August 29 to September 8, 1881, under GLO Contract No. 388, dated May 7, 1881.

A stone, 12" x 12" x 8" was set for the corner point from which:

A 24" dia. Fir bears S. 65° E. at 16 lks. dist.  
A 10" dia. Western Larch bears N. 55° E. at 22 lks. dist.

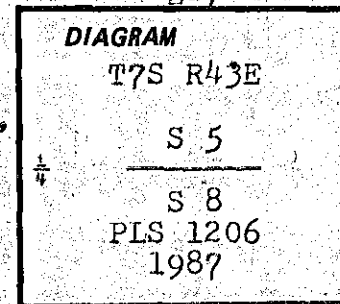

Description of corner evidence found:

Found a 36" dia. Douglas Fir sawed stump 2 ft. high bearing S. 65° E. at 16 lks. dist. mkd. with "T" scribe visible, the rest of the scribe has been logged away.

Found a 18" dia. Western Larch sawed stump 2 ft. high bearing N. 55° E. at 22 lks. dist. mkd., no scribe visible on blaze.

Found a 12 in. x 11 in. x 9 in. stone, set in above referenced position, mkd. with 1/4 on top of stone.

Description of monument and accessories established to perpetuate the original location of this corner:

At record bearing and distance from original bearing tree remnants and at the recovered stone position:

Set a 2 1/2" x 30" alum. pipe with a 2 1/2" alum. cap 24" into the ground. Constructed a 48" stone mound around the monument. The cap is marked as shown in the corner diagram.

From the corner point:

A 10" dia. White Fir bears N. 72° E. at 20.5 ft. dist., mkd. 1/4 S 5 BT.  
A 16" dia. White Fir bears S. 17° E. at 45.9 ft. dist., mkd. 1/4 S 8 BT.

Set a steel fence post 4 ft. from the monument and attached a USFS 54-9 sign. Painted the face of the blaze and a 6 in. band around the bearing trees red. I.D. washers were nailed between the scribed B and T of the new bearing trees. The washers are 3/4" in diameter and made of brass with PLS 1206 stamped on one side. Attached USFS 54-9 and 54-3 signs to bearing trees. Used 18 1/2° declination on a staff compass for readings to bearing trees. Used a steel tape to measure to a nail set in the side of the trees.


This corner was monumented to USFS specifications on July 28, 1987, witnessed by Tom Fisk and Andy Marlette.

Office of Baker County Surveyor, County of Baker  
State of OR, I hereby certify that the within instrument was filed in this office  
for record on the        day of       , 19      

(COUNTY OFFICIAL)

(DEPUTY)

Form R6-7100-57 (9/71)

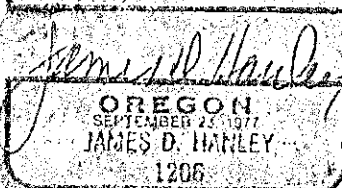

☆ GPO-798-276

FILED 10/18/88  
BAKER COUNTY SURVEYOR  
SURVEY NO. 7-43-146