


CERTIFIED RECORD OF LAND CORNER MONUMENTATION

F-2

History of original corner establishment:

None previously established.

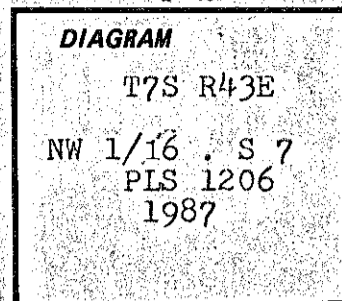

Description of corner evidence found:

None

Description of monument and accessories I established to perpetuate the original location of this corner:


Set a 2 1/2" x 30" alum. pipe with a 2 1/2" alum. cap 24" into the ground. Constructed a 36" dia. stone mound around the monument. The cap is marked as shown in the corner diagram.

This record is one of three, the other two being Witness Corners for this corner which is below high water mark in Balm Creek Reservoir.

This corner was monumented to USFS specifications on August 3, 1987, witnessed by Tom Fisk, Larry McBroom and Andy Marlette.

Office of County Surveyor County of Baker
 State of OR, I hereby certify that the within instrument was filed in this office
 for record on the day of , 19
 _____ by _____
 (COUNTY OFFICIAL) (DEPUTY)

Form R6-7100-57 (9/71)

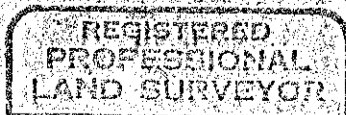

James D. Hanley
 OREGON
 SEPTEMBER 23, 1977
 JAMES D. HANLEY
 1206

☆ GPO-798-276

FILED 10/18/88
 BAKER COUNTY SURVEYOR
 SURVEY NO. 743-118