


CERTIFIED RECORD OF LAND CORNER MONUMENTATION

G-3

History of original corner establishment:

None previously established.

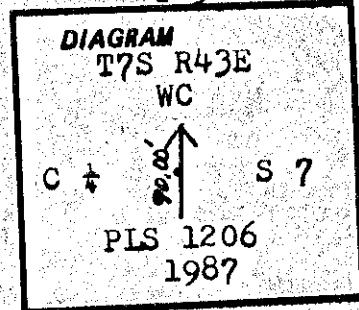

Description of corner evidence found:

None

Description of monument and accessories I established to perpetuate the original location of this corner:

Set a $2\frac{1}{2}$ " x 30" alum. pipe with a $2\frac{1}{2}$ " alum. cap 18" into the ground. Constructed a 36" dia. stone mound around the monument. The cap is marked as shown in the corner diagram.

From the corner point: (Witness Corner) The corner was set S. $0^{\circ} 05' 50''$ W. $90'$ from true corner location.


A 12" dia. Ponderosa Pine bears N. 74° W. at 32.2 ft. dist., mkd. X BT.
A 15" dia. Ponderosa Pine bears S. 38° W. at 18.1 ft. dist., mkd. X BT.

The corner point lands in the center of a road around the East side of Balm Creek Reservoir.

Set a steel fence post 4 ft. South of the WC monument and attached USFS 54-9 and 54-2 signs. Painted the face of the blaze and a 6 in. band around the bearing trees red. Ident. washers were nailed between the scribed B and T of the new bearing trees. Washers are $\frac{3}{4}$ in. diameter, made of brass, with PLS 1206 stamped on one side. Attached USFS 54-9 and 54-3 signs to the bearing trees. Used $18\frac{1}{2}^{\circ}$ declination on a staff compass for readings to bearing trees. Used a steel tape to measure to a nail set in the side of trees.

This corner was monumented to USFS specifications on August 4, 1987, witnessed by Tom Fisk and Andy Marlette.

Office of..... County Surveyor..... County of..... Baker.....
State of..... OR..... I hereby certify that the within instrument was filed in this office
for record on the..... day of..... , 19.....
..... by
(COUNTY OFFICIAL) (DEPUTY)

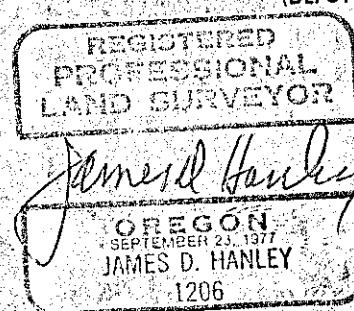

* GPO - 798-274

Form R6-7100-57 (9/71)

FILED 10/18/88
BAKER COUNTY SURVEYOR
SURVEY NO. 17-43-151