

CERTIFIED RECORD OF LAND CORNER MONUMENTATION

G-5


History of original corner establishment:

W. B. Barr conducted the survey of Township 7 South, Range 43 East, W.M., August 29 to September 8, 1881, under GLO Contract No. 388, dated May 7, 1881.

The original notes of that survey relative to this corner state the following:

Marked basalt rock, 16" x 12" x 8" for $\frac{1}{4}$ sec. corner, from which:

- A Western Larch, 18 ins. dia., bears N. 60° E., at 27 lks. dist.
- A Fir, 24 ins. dia., bears S. 65° W., at 20 lks. dist.

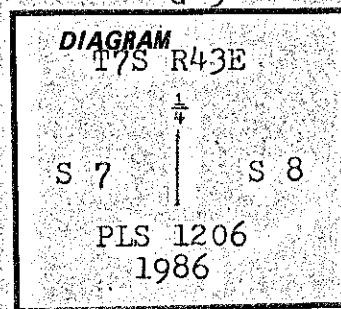

Description of corner evidence found:

Found a basalt stone, 16" x 12" x 8" with $\frac{1}{4}$ chiselled on the side. The stone had been relocated from road construction directly over the corner point.

Original bearing trees:

A Western Larch, 23 ins. dia., bears N. 60° E., at 17.8 ft. dist., mkd. $\frac{1}{4}$ S., the rest of the scribe is healed over.

A Douglas Fir, 32 ins. dia., bears S. 65° W., at 13.2 ft. dist., mkd. scribe visible but not legible, on partially healed blaze.

At the time of remonumentation both bearing trees were in good healthy shape.

Description of monument and accessories established to perpetuate the original location of this corner: From the cor. point:

Corner point reestablished from record brngs. and dist. from original found bearing trees.

Set a 2 $\frac{1}{2}$ " x 30" alum. pipe with a 2 $\frac{1}{2}$ " alum. cap. Top of cap is 2 ins. below ground level. Constructed a 36" dia. stone mound around the corner point. The cap is marked as shown in the corner diagram. Buried the original corner stone 1 ft. North of the new monument.


Set a steel fence post 3 ft. North of the monument and attached a 54-9 USFS sign. Painted the face of the blaze and a 6 in. band around the bearing trees red. Attached USFS 54-9 and 54-3 signs to bearing trees. Used 18 $\frac{1}{2}$ ° declination on a staff compass for readings to bearing trees.

Corner point is on an old abandoned little used road. Monument was set below surface in case of increased usage of said road.

This corner was remonumented to USFS specifications on December 8, 1986, witnessed by Tom Fisk and Larry McBroom.

Office of County Surveyor County of Baker
 State of OR I hereby certify that the within instrument was filed in this office
 for record on the day of , 19
 by (DEPUTY)
 (COUNTY OFFICIAL)

Form R6-7100-57 (9/71)

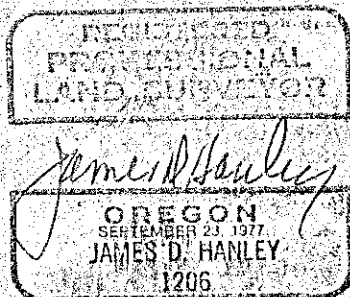

FILED 10/18/88
 BAKER COUNTY SURVEYOR
 SURVEY NO. 7-43-152