


CERTIFIED RECORD OF LAND CORNER MONUMENTATION

G-7

History of original corner establishment:

None previously established.

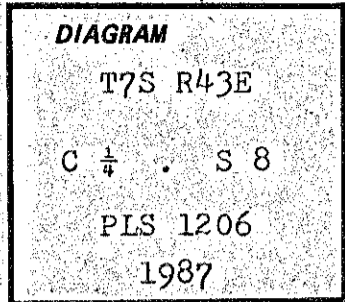

Description of corner evidence found:

None

Description of monument and accessories established to perpetuate the original location of this corner:

Set a 2 1/2" x 30" alum. pipe with a 2 1/2" alum. cap 20" into the ground. Constructed a 36" dia. stone mound around the monument. The cap is marked as shown in the corner diagram.

From the corner point:

A 18" Ponderosa Pine bears S. 57° W., at 37.7 ft. dist. mkd. C 1/4 S8 BT.  
A 18" Douglas Fir bears N. 57° W., at 47.8 ft. dist. mkd. C 1/4 S8 BT.

Set a steel fence post 4 ft. from the monument and attached a USFS 54-9 sign. Painted the face of the blaze and a 6 in. band around the bearing trees red. I.D. washers were nailed between the scribed B and T of the new bearing trees. The washers are 3/4" in diameter and made of brass with PLS 1206 stamped on one side. Attached USFS 54-9 and 54-3 signs to bearing trees. Used 18 1/2° declination on a staff compass for readings to bearing trees. Used a steel tape to measure to a nail set in the side of the trees.

This corner was monumented to USFS specifications on July 28, 1987, witnessed by Tom Fisk and Andy Marlette.

Office of County Surveyor County of Baker  
State of OR I hereby certify that the within instrument was filed in this office  
for record on the        day of       , 19      

(COUNTY OFFICIAL)

REGISTERED  
PROFESSIONAL  
LAND SURVEYOR

*James D. Hanley*  
OREGON  
REGISTERED  
JAMES D. HANLEY  
1206

(DEPUTY)

Form R6-7100-57 (9/71)

★ GPO—798-276  
FILED 10/18/88  
BAKER COUNTY SURVEYOR  
SURVEY NO. 7-43-153