


CERTIFIED RECORD OF LAND CORNER MONUMENTATION

H-2

History of original corner establishment:

None previously established.

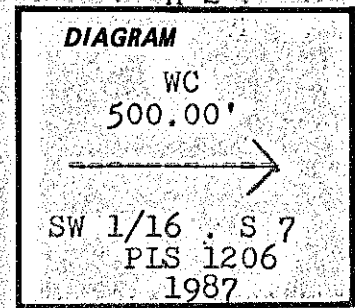

Description of corner evidence found:

None

Description of monument and accessories established to perpetuate the original location of this corner:

Set a 2 1/2" x 30" alum. pipe with a 2 1/2" alum. cap 24" into the ground. Constructed a 36" dia. stone mound around the monument. The cap is marked as shown in the corner diagram.

From the corner point:

A 8" dia. Lodgepole Pine bears S. 33° W. at 15.8 ft. dist., mkd. (X) BT.

A 10" dia. Western Larch bears S. 57° E. at 37.0 ft. dist., mkd. (X) BT.

Set a steel fence post 4 ft. from the monument and attached a USFS 54-9 sign. Painted the face of the blaze and a 6 in. band around the bearing trees red. I.D. washers were nailed between the scribed B and T of the new bearing trees. The washers are 3/4" in diameter and made of brass with PLS 1206 stamped on one side. Attached USFS 54-9 and 54-3 signs to bearing trees. Used 18 1/2° declination on a staff compass for readings to bearing trees. Used a steel tape to measure to a nail set in the side of the trees.

This Witness Corner was set N. 81° 54' 59" W., 500.0 ft. from the true point on the line between lot 3 and 4.


This corner was monumented to USFS specifications on August 3, 1987, witnessed by Tom Fisk, Larry McBroom and Andy Marlette.

Office of County Surveyor County of Baker State of OR I hereby certify that the within instrument was filed in this office for record on the day of 19

(COUNTY OFFICIAL)

(DEPUTY)

Form R6-7100-57 (9/71)

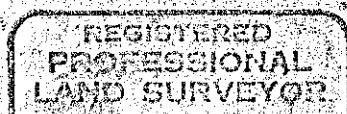

James D. Hanley OREGON PROFESSIONAL LAND SURVEYOR JAMES D. HANLEY 1206

☆ GPO—798-276

FILED 10/18/88 BAKER COUNTY SURVEYOR SURVEY NO. 7-413-154