


CERTIFIED RECORD OF LAND CORNER MONUMENTATION

H-6

History of original corner establishment:

None previously established.

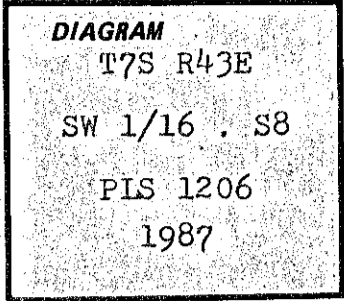

Description of corner evidence found:

None

Description of monument and accessories established to perpetuate the original location of this corner:

Set a 2½" x 30" alum. pipe with a 2½" alum. cap 22" into the ground. Constructed a 36" dia. stone mound around the monument. The cap is marked as shown in the corner diagram.

From the corner point:

- A 11" dia. Ponderosa Pine, bears S. 62° W. at 20.0 ft. dist. mkd. SW 1/16 S8 BT.
- A 10" dia. Ponderosa Pine, bears N. 34° W. at 43.7 ft. dist. mkd. SW 1/16 S8 BT.

Set a steel fence post 4 ft. S. from the monument and attached a USFS 54-9 and 54-2 signs. Painted the face of the blaze and a 6 in. band around the bearing trees red. I.D. washers were nailed between the scribed B and T of the new bearing trees. The washers are ¾" in diameter and made of brass with PLS 1206 stamped on one side. Attached USFS 54-9 and 54-3 signs to bearing trees. Used 18½" declination on a staff compass for readings to bearing trees. Used a steel tape to measure to a nail set in the side of the trees.


This corner was monumented to USFS specifications on July 27, 1987, witnessed by Tom Fisk and Andy Marlette.

Office of..... County Surveyor..... County of..... Baker
State of..... OR....., I hereby certify that the within instrument was filed in this office
for record on the..... day of....., 19.....

(COUNTY OFFICIAL)

(DEPUTY)

Form R6-7100-57 (9/71)

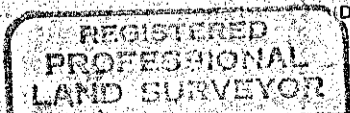

James D. Hanley
OREGON
SEPTEMBER 29, 1977
JAMES D. HANLEY
1206

☆ GPO—798-276

FILED 10/18/88
BAKER COUNTY SURVEYOR
SURVEY NO. 7-43-158