

CERTIFIED RECORD OF LAND CORNER MONUMENTATION

J-3


History of original corner establishment:

W. B. Barr conducted the survey of Township 7 South, Range 43 East, W.M., August 29 to September 8, 1881, under GLO Contract No. 388, dated May 7, 1881.

The original notes of that survey relative to this corner state the following:

Set a stake 4 ft. long, 4 ins. in dia., 18 ins. into the ground for $\frac{1}{4}$ sec. corner from which:

- A Pine, 18 ins. dia., bears S. 35° W., at 7 lks. dist.
- A Western Larch, 15 ins. dia., bears N. 32° E., at 10 lks. dist.

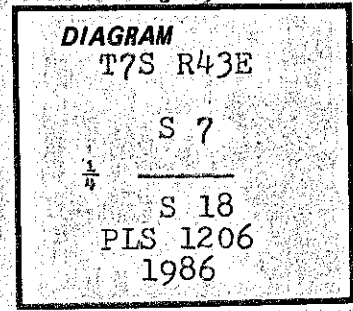

Description of corner evidence found:

Found a rotted and down stump of indeterminate size, bears approximately N. 32° E., at 6.6 ft. dist., mkd. with chop marks. A Ponderosa Pine, 27" in dia., bears S. 35° W., at 4.6 ft. dist., mkd. S. the rest of the scribe is healed over. This tree is alive and healthy.

Description of monument and accessories established to perpetuate the original location of this corner:

Set a $2\frac{1}{2}$ " x 30" alum. pipe with a $2\frac{1}{2}$ " alum. cap 27 ins. into the ground and constructed a 36" dia. stone mound around it. The cap is marked as shown in the corner diagram. From the corner point:

- A White Fir, 8" dia., bears N. 42° W., at 7.9 ft. dist., mkd. $\frac{1}{4}$ S7 BT.


Set a steel fence post 4 ft. West of the monument and attached a USFS 54-9 sign. Painted the face of the blaze and a 6 in. red band around the bearing trees. I.D. washers were nailed between the scribed B and T of the new bearing trees. The washers are $\frac{3}{4}$ " in diameter and made of brass with PLS 1206 stamped on one side. Attached USFS 54-9 and 54-3 signs to the bearing trees. Used $18\frac{1}{2}^{\circ}$ declination on a staff compass for readings to bearing trees. Used steel tape to measure to a nail set in the side of the trees.

The corner was set from evidence of the old bearing trees.

This corner was remonumented to USFS specifications on September 15, 1986, witnessed by Tom Fisk and Larry McBroom.

Office of County Surveyor County of Baker
 State of OR I hereby certify that the within instrument was filed in this office
 for record on the day of , 19
 _____ by _____
 (COUNTY OFFICIAL) (DEPUTY)

Form R6-7100-57 (9/71)

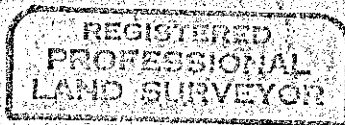

James D. Hanley
 OREGON
 SEPTEMBER 23, 1977
 JAMES D. HANLEY
 1206

☆ GPO—798-276

FILED 10/18/88
 BAKER COUNTY SURVEYOR
 SURVEY NO. 7-43-160