

CERTIFIED RECORD OF LAND CORNER MONUMENTATION

J-7


History of original corner establishment:

W. B. Barr conducted the survey of Township 7 South, Range 43 East, W.M., August 29 to September 8, 1881, under GLO Contract No. 388, dated May 7, 1881.

The original notes of that survey relative to this corner state the following:

Marked a basalt rock, 12" x 10" x 5" for $\frac{1}{4}$ sec. corner, from which:

- A Pine, 15" dia., bears S. 8° W. at 135 lks. dist.
- A Pine, 24" dia., bears N. $12\frac{1}{2}^{\circ}$ W. at 70 lks. dist.

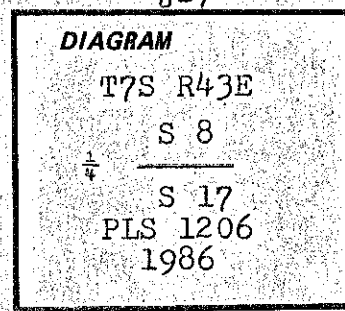

Description of corner evidence found:

Found a basalt stone 12" x 10" x 6" with $\frac{1}{4}$ chiselled into the side of it. Stone was lying over, in record position.

Old bearing trees:

- A 24" stump bears N. $12\frac{1}{2}^{\circ}$ W., at 46.2 ft. dist., mkd. with one scribe line visible.
- A 17" rotted log bears S. 8° W., at 89.7 ft. dist., mkd. BT. The rest of the scribe is healed over.

Description of monument and accessories I established to perpetuate the original location of this corner:

At position of original stone:

Set a $2\frac{1}{2}$ " x 30" alum. pipe with a $2\frac{1}{2}$ " alum. cap 24 ins. into the ground. Constructed a 36 in. dia. stone mound around the monument. The cap is marked as shown in the corner diagram. Buried the original corner stone 1 ft. North of the new monument.

From the corner point:

New BT's

- A Ponderosa Pine, 10 ins. dia., bears S. 10° E., at 37.9 ft. dist., mkd. $\frac{1}{4}$ S 17 BT.
- A Ponderosa Pine, 12 ins. dia., bears N. 88° W., at 38.4 ft. dist., mkd. $\frac{1}{4}$ S 8 BT.

Set a steel fence post 4 ft. West of the monument and attached a 54-9 USFS sign. Painted the face of the blaze and a 6 in. band around the bearing trees red. I.D. washers were nailed between the scribed B and T of the new bearing trees. The washers are $\frac{3}{4}$ " in diameter and made of brass with PLS 1206 stamped on one side. Attached USFS 54-9 and 54-3 signs to bearing trees. Used $18\frac{1}{2}^{\circ}$ declination on a staff compass for readings to bearing trees. Used a steel tape to measure to a nail set in the side of the trees.

This corner was remonumented to USFS specifications on December 12, 1986, witnessed by Tom Fisk and Larry McBroom.


Office of..... County Surveyor County of..... Baker

State of..... OR I hereby certify that the within instrument was filed in this office for record on the..... day of....., 19.....

..... by

(COUNTY OFFICIAL) (DEPUTY)

Form R6-7100-57 (9/71)

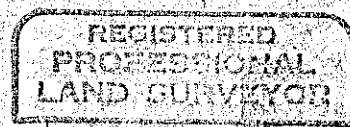

James D. Hanley

OREGON
SEPTEMBER 23, 1977
JAMES D. HANLEY
1206

☆ GPO—798-276

FILED 10/18/88
BAKER COUNTY SURVEYOR
SURVEY NO. 7-43-164