


CERTIFIED RECORD OF LAND CORNER MONUMENTATION

History of original corner establishment:

W. B. Barr conducted the survey of Township 7 South, Range 43 East, W.M., August 29 to September 8, 1881, under GLO Contract No. 388, dated May 7, 1881. The original notes of that survey relative to this corner, state the following:

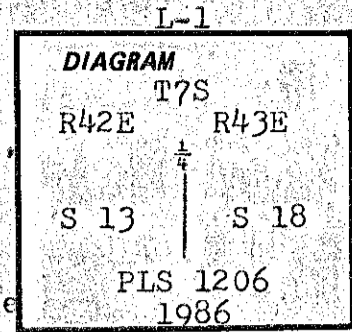

Set stake 4 ft. long 4 ins. dia., 18 ins. in the ground for  $\frac{1}{4}$  sec. corner from which:

- A Pine, 6 ins. dia. bears N. 72° E. at 49 lks. dist.
- A Pine, 3 ins. dia. bears S. 83° W. at 44 lks. dist.

Description of corner evidence found:

No evidence was found after 12 man hours of searching. The area has been logged several times and there is evidence of an old forest fire.

Description of monument and accessories established to perpetuate the original location of this corner:

At proportionate point:

Set a 2½" x 30" alum. pipe with a 2½" alum. cap 24 ins. into the ground. Constructed a 36 in. dia. stone mound around the monument. The cap is marked as shown in the corner diagram. From the corner point:

- A Ponderosa Pine, 13 ins. dia., bears N. 69° E., at 38.0 ft. dist., mkd.  $\frac{1}{4}$  S 18 BT.
- A Ponderosa Pine, 11 ins. dia., bears S. 13° W., at 49.9 ft. dist., mkd.  $\frac{1}{4}$  S 13 BT.


Set a steel fence post 5 ft. to the North of the monument and attached a USFS 54-9 sign. Painted the face of the blaze and a 6 in. band around the bearing trees red. I.D. washers were nailed between the scribed B and T of the new bearing trees. The washers are 3/4" in diameter and made of brass with PLS 1206 stamped on one side. Attached USFS 54-9 and 54-3 signs to bearing trees. Used 18½° declination on a staff compass for readings to bearing trees. Used steel tape to measure to a nail set in the side of the trees.

This corner was remonumented to USFS specifications on August 27, 1986, witnessed by Tom Fisk, Larry McBroom and Wade Stone.

Office of.....County Surveyor..... County of..... Baker  
 State of.....OR..... I hereby certify that the within instrument was filed in this office  
 for record on the..... day of....., 19.....

..... by .....  
 (COUNTY OFFICIAL) (DEPUTY)

Form R6-7100-57 (9/71)

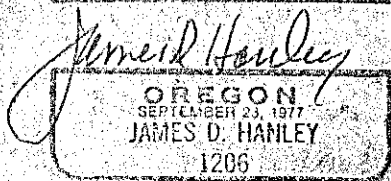

☆ GPO—798-276

FILED 10/18/88  
 BAKER COUNTY SURVEYOR  
 SURVEY NO. 7-43-167  
 7-42-12