

CERTIFIED RECORD OF LAND CORNER MONUMENTATION

N-3

History of original corner establishment:


W. B. Barr conducted the survey of Township 7 South, Range 43 East, W.M., August 29 to September 8, 1881, under GLO Contract No. 388, dated May 7, 1881.

The original notes of that survey relative to this corner state the following:

Marked basalt rock 12" x 9" x 5" for  $\frac{1}{4}$  sec. corner, from which:

A Pine, 24" dia. bears S.  $34^{\circ}$  E. at 110 lks. dist.

A Pine, 18" dia. bears W.  $55^{\circ}$  E. at 120 lks. dist.

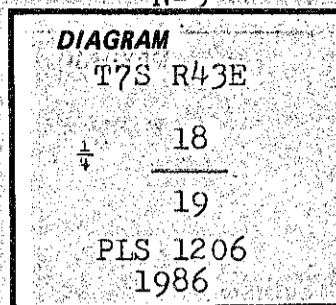

Description of corner evidence found:

No evidence found in the area of corner location. A total of 18 man hours of searching was expended. The area has been heavily logged as well as a forest fire has gone through the area and destroyed all evidence.

Description of monument and accessories established to perpetuate the original location of this corner:

At the proportionate corner point set a  $2\frac{1}{2}$ " x 30" alum. pipe with a  $2\frac{1}{2}$ " alum. cap 14" into the ground. Constructed a 48" dia. stone mound around the monument. Cap is marked as shown in the corner monument. From the corner point:

A 15" Ponderosa Pine bears S.  $69^{\circ}$  W., at 22.4 ft. dist., mkd.  $\frac{1}{4}$  S 19 BT.


A 13" Ponderosa Pine bears N.  $36^{\circ}$  W., at 78.3 ft. dist., mkd.  $\frac{1}{4}$  S 18 BT.

Set a steel fence post 4 ft. from the monument and attached a USFS 54-9 sign. Painted the face of the blaze and a 6 in. band around the bearing trees red. I.D. washers were nailed between the scribed B and T of the new bearing trees. The washers are  $\frac{3}{4}$ " in diameter and made of brass with PLS 1206 stamped on one side. Attached USFS 54-9 and 54-3 signs to bearing trees. Used  $18\frac{1}{2}^{\circ}$  declination on the staff compass for readings to the bearing trees. Used a steel tape to measure to a nail set in the side of the base of the bearing tree trunks.

This corner was monumented to USFS specifications on December 1, 1986, witnessed by Tom Fisk and Larry McBroom.

Office of..... County Surveyor ..... County of..... Baker .....  
 State of..... OR ..... I hereby certify that the within instrument was filed in this office  
 for record on the..... day of....., 19.....  
 ..... by .....  
 (COUNTY OFFICIAL) (DEPUTY)

Form R6-7100-57 (9/71)

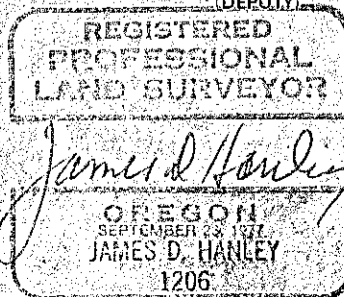

★ GPO—798-276

FILED 10/18/88  
 BAKER COUNTY SURVEYOR  
 SURVEY NO. 7-13-175