

CERTIFIED RECORD OF LAND CORNER MONUMENTATION

0-1

History of original corner establishment:

None, corner is established this survey.

DIAGRAM
T 7 S
R 42 E R 43 E
N 1/16

S 24 S 19
PLS 1206
1986

Description of corner evidence found:

None.

Description of monument and accessories I established to perpetuate the original location of this corner:

Set a $2\frac{1}{2}$ in. x 30 in. alum. pipe with a $2\frac{1}{2}$ in. alum cap 10 ins. into the ground. Constructed a 36 in. diam. stone mound around the monument. The cap is marked as shown in the corner diagram.

From the corner point:


A Ponderosa pine, 31 ins. diam., bears S. 56° E., 156.9 ft. dist., mkd. N 1/16 S 19 BT. A 5 ft. x 3 ft. x 2 ft. stone bears N. 71° W., 33.9 ft. dist., mkd X BO.on South face.

Set a steel fence post 4 ft. South and a steel fence post 4 ft. East of the monument and attached a USFS 54-9 and a 54-2 sign. Attached USFS 54-9 and 54-3 signs to the bearing tree. Painted the face of the blaze and a 6 in. band around the bearing tree and the X BO on the bearing object red. Attached a 3/4 in. brass washer mkd. PLS 1206 to the bearing tree between the B and T scribes at base of BT. Used a steel tape and staff compass with $18\frac{1}{2}^\circ$ declination for measurements to bearing tree and the bearing object.


This corner was monumented to USFS specifications on Dec. 22, 1986, witnessed by Tom Fisk and Larry McBroom.

Office of..... County Surveyor..... County of.... Baker.....
State of..... Oregon....., I hereby certify that the within instrument was filed in this office
for record on the..... day of..... , 19.....
..... by
(COUNTY OFFICIAL)

(DEPUTY)

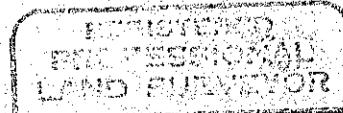

★ GPO 798-270

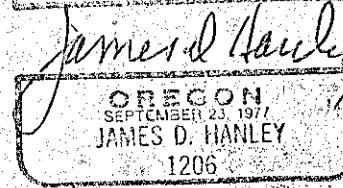

FILED 10/18/88
BAKER COUNTY SURVEYOR
SURVEY NO. 7-43-178
7-43-13

Form R6-7100-57 (9/71)