


CERTIFIED RECORD OF LAND CORNER MONUMENTATION

0-3

History of original corner establishment:

None, corner is established this survey.

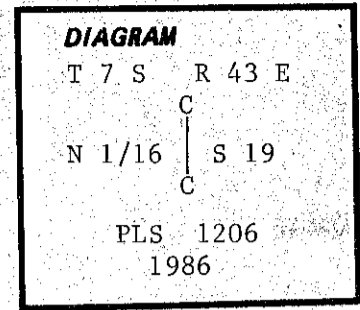

Description of corner evidence found:

None

Description of monument and accessories | established to perpetuate the original location of this corner:

Set a 2½ in. x 30 in. alum. pipe with a 2½ in. alum. cap 24 ins. into the ground. Constructed a 36 ins. stone mound around the monument. The cap is marked as shown in the corner diagram.

From the corner point:

A Ponderosa pine 30 ins. diam. bears S. 63° E., 34.8 ft. dist., mkd. C N1/16 S 19 BT. A boulder, 4 ft. x 3 ft. x 2 ft. high bears S. 58° W., 43.2 ft., dist., mkd. X BO on the top East face.

Set a steel fence post 4 ft. from the monument and attached a USFS 54-9 sign. Attached USFS 54-9 and 54-3 signs to the bearing tree. Painted the face of the blaze and a 6 in. band around the bearing tree and the X BO red. Attached 3/4 in. brass washer mkd. PLS 1206 to the bearing tree between the B and T scribes at base of BT. Used a steel tape and staff compass with 18½° declination for measurements to bearing tree and the bearing object.

This corner was remonumented to USFS specifications Dec. 12, 1986, witnessed by Tom Fisk and Larry McBroom.

Office of.....County Surveyor..... County of Baker.....  
 State of.....Oregon....., I hereby certify that the within instrument was filed in this office  
 for record on the..... day of....., 19.....  
 ..... by .....  
 (COUNTY OFFICIAL) (DEPUTY)

Form R6-7100-57 (9/71)

REGISTERED  
 PROFESSIONAL  
 LAND SURVEYOR

☆ GPO-798-278

*James D. Hanley*  
 OREGON  
 SEPTEMBER 23, 1977  
 JAMES D. HANLEY  
 1206

FILED 10/18/88  
 BAKER COUNTY SURVEYOR  
 SURVEY NO. 7-43-179