

CERTIFIED RECORD OF LAND CORNER MONUMENTATION

0-7

History of original corner establishment:

None previously established.

DIAGRAM
T7S R43E
C
N 1/16 S 20
C
PLS 1206
1986

Description of corner evidence found:

None

Description of monument and accessories I established to perpetuate the original location of this corner:

Set a $2\frac{1}{2}$ " x 30" alum. pipe with a $2\frac{1}{2}$ " alum. cap 24" into the ground. Constructed a 36 in. dia. stone mound around the monument. The cap is marked as shown in the corner diagram.

From the corner point:

Ponderosa Pine, 11 ins. dia., bears N. 29° E., at 38.5 ft. dist., mkd. CN 1/16 S 20 BT.

Ponderosa Pine, 10 ins. dia., bears N. 81° W., at 7.1 ft. dist., mkd. CN 1/16 S 20 BT.


Set a steel fence post 4 ft. West and set another post 4 ft. to the South from the monument and attached a USFS 54-9 and 54-2 signs. Painted the face of the blaze and a 6 in. band around the bearing trees red. I.D. washers were nailed between the scribed B and T of the new bearing trees. The washers are $\frac{3}{4}$ " in diameter and made of brass with PLS 1206 stamped on one side. Attached USFS 54-9 and 54-3 signs to bearing trees. Used $18\frac{1}{2}^{\circ}$ declination on a staff compass for readings to bearing trees. Used a steel tape to measure to a nail set in the side of the base of the bearing tree trunks.

This corner was monumented to USFS specifications on December 23, 1986, witnessed by Tom Fisk and Larry McBroom.

Office of..... County Surveyor..... County of..... Baker.....

State of..... OR..... I hereby certify that the within instrument was filed in this office for record on the..... day of..... 19.....

..... by.....
(COUNTY OFFICIAL)

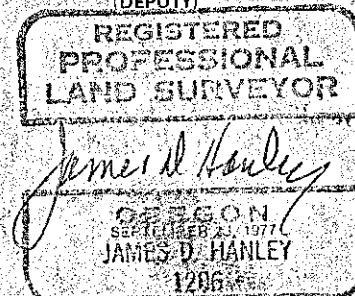

★ GPO - 798-275

Form R6-7100-57 (9/71)

FILED 10/18/88
BAKER COUNTY SURVEYOR
SURVEY NO. 7-413-183