


CERTIFIED RECORD OF LAND CORNER MONUMENTATION

P-4

History of original corner establishment:

None, corner established this survey.

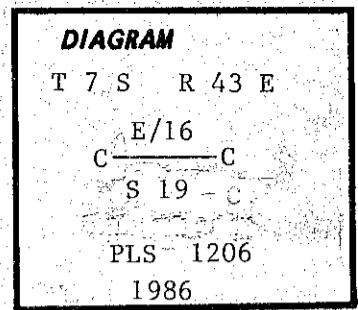

Description of corner evidence found:

None

Description of monument and accessories established to perpetuate the original location of this corner:

At the corner point:

Set a 2½ in. x 30 in. alum. pipe with a 2½ alum. cap 18 ins. into the ground. Constructed a 36 in. diam. stone mound around the monument. The cap is marked as shown in the corner diagram.

From the corner point:

A boulder, 3 ft. x 2 ft. x 1 ft. bears N. 60° W., 44.3 ft. dist., mkd. X BO on the top of the West end.


A boulder, 3 ft. x 2 ft. x 1 ft. bears N. 38° E., 45.9 ft. dist., mkd. X BO on top of the East end.

Set a steel fence post 4 ft. from the monument and attached a USFS 54-9 sign. Used a steel tape and staff compass set with 18½° declination for measurements to X on bearing objects. Painted the X BO's red.

This corner was remonumented to USFS specifications on Dec. 18, 1986, witnessed by Tom Fisk and Larry McBroom.

County Surveyor _____ Baker
 Office of _____ County of _____
 State of Oregon _____, I hereby certify that the within instrument was filed in this office
 for record on the _____ day of _____, 19____
 _____ by _____
 (COUNTY OFFICIAL) (DEPUTY)

Form R6-7100-57 (9/71)

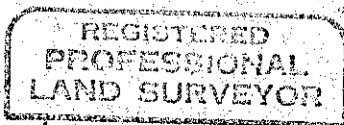

James D. Hanley

OREGON
 SEPTEMBER 21, 1977
 JAMES D. HANLEY
 1206

★ GPO—799,279

FILED 10/18/86
 BAKER COUNTY SURVEYOR
 SURVEY NO. 7-43-186