

CERTIFIED RECORD OF LAND CORNER MONUMENTATION


P-5

History of original corner establishment:

W. B. Barr conducted the survey of Township 7 South, Range 43 East, W.M., August 29 to September 8, 1881, under GLO Contract No. 388, dated May 7, 1881.

The original notes of that survey relative to this corner state the following:

Marked a basalt rock 18 ins. x 12 ins. x 8 ins. for 1/4 section corner. Raised a mound of rock as per instructions.

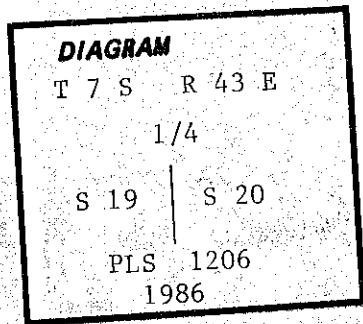

Description of corner evidence found:

None. A total of 8 man-hours expended in search of this corner.

Description of monument and accessories established to perpetuate the original location of this corner:

At the proportioned corner location:

Set a 2½ in. x 30 in. alum. pipe with a 2½ in. alum cap 24 ins. into the ground. Constructed a 36 in. stone mound around the monument. The cap is marked as shown in the corner diagram.

From the corner point:

A stone, not imbedded, 36 in. x 18 in. x 8 in. bears N. 70° E., 16.5 ft. dist., mkd. X BO top of stone.

A stone, 36 in. x 36 in. x 24 in. bears N. 20° W., 48.6 ft. dist., mkd. X BO on South face

Set a steel fence post 4 ft. North of the monument and attached a USFS 54-9 sign. Used a steel tape and staff compass set with 18½° declination for measurements to X BO on the bearing objects. Painted the X BO's red.

This corner was remonumented to USFS specifications on Dec. 19, 1986, witnessed by Tom Fisk and Larry McBroom.

Office of..... County Surveyor..... County of... Baker.....
Oregon
State of....., I hereby certify that the within instrument was filed in this office
for record on the..... day of....., 19.....
..... by (DEPUTY)
(COUNTY OFFICIAL)

Form R6-7100-57 (9/71)

REGISTERED
PROFESSIONAL
LAND SURVEYOR

James D Hanley
OREGON
SEPTEMBER 23, 1977
JAMES D. HANLEY
1206

☆ GPO-798-276

FILED 10/18/86
BAKER COUNTY SURVEYOR
SURVEY NO. 7543-18