


CERTIFIED RECORD OF LAND CORNER MONUMENTATION

R-5

History of original corner establishment:

W. B. Barr conducted the survey of Township 7 South, Range 43 East, W.M., August 29 to September 8, 1881, under GLO Contract No. 388, dated May 7, 1881.

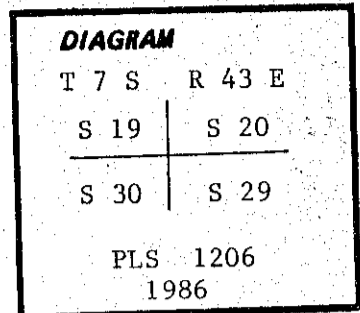

The original notes of that survey relative to this corner state the following:

Set stake 4 ft. long, 4 ins. diam., 18 ins. in the ground for corner to sections 19, 20, 29 and 30. Raised mound of rock as per instructions.

Description of corner evidence found:

Accepted ancient fence intersection as best remaining evidence of perpetuated corner location.

Description of monument and accessories | established to perpetuate the original location of this corner: At accepted fence corner point:

Set a 2½ in. x 30 in. alum. pipe with a 2½ in. alum. cap 18 ins. into the ground. Constructed a 36 ins. diam. stone mound around the monument. The cap is marked as shown in the corner diagram.
From the corner point:

- A 3 ft. x 3 ft. x 1 ft. stone bears N. 28° W., 47.3 ft. dist., mkd. X BO on top SE end.
- A 3 Ft. x 3 ft. x 4 ft. stone bears S. 56° W., 88.7 ft. dist., mkd. X BO on flat top.
- A 2 ft. x 2 ft. x 1 ft. stone bears S. 49° E., 25.9 ft. dist., mkd. X BO on top.
- A 5/8 in. x 30 in. rebar bears N. 50° E., 25.0 ft. dist., with yellow plastic cap mkd. Hanley Engr. PLS 1206, set flush with ground.

Set a steel fence post 4 ft. North of the monument and attached a USFS 54-9 sign. Used a steel tape and staff compass set with 18½° declination for measurements to X on bearing objects
Painted the X BO's red.

This corner was remonumented to USFS specifications on Aug. 5, 1987, witnessed by Tom Fisk and Andy Marlette.

Office of..... County Surveyor..... County of..... Baker.....
 State of..... Oregon..... I hereby certify that the within instrument was filed in this office
 for record on the..... day of....., 19.....
 by

(COUNTY OFFICIAL)

(DEPUTY)

REGISTERED
 PROFESSIONAL
 LAND SURVEYOR

★ GPO—786-178

James D. Hanley
 OREGON
 SEPTEMBER 23, 1977
 JAMES D. HANLEY
 1206

FILED 10/18/88
 BAKER COUNTY SURVEYOR
 SURVEY NO. 7-43-192