

CERTIFIED RECORD OF LAND CORNER MONUMENTATION


T-1

**History of original corner establishment:**

W. B. Barr conducted the survey of Township 7 South, Range 43 East, W.M., August 29 to September 8, 1881, under GLO Contract No. 388, dated May 7, 1881.

The original notes of that survey relative to this corner state the following:

Marked a basalt stone 18 ins. x 8 ins. x 6 ins. for 1/4 sec. corner. Raised a mound of rock as per instructions.

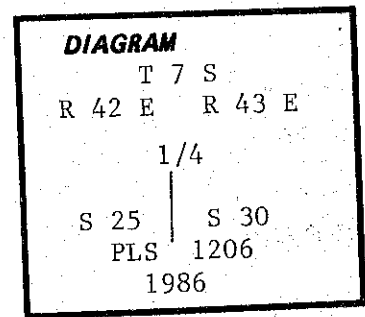

**Description of corner evidence found:**

Found a basalt stone 20 ins. x 10 ins. x 7 ins. layed over in a large stone mound, marked with 1/4 scratched on face.

**Description of monument and accessories | established to perpetuate the original location of this corner:**

At the position of the recovered stone:

Set a 2 1/2 in. x 30 in. alum. pipe with a 2 1/2 in. alum. cap 24 in. into the ground. Constructed a 36 in. diam. stone mound around the monument. Deposited the original stone 1 ft. North of the monument.

From the corner point:


A well-set stone, 24 ins. x 14 ins. x 12 ins. bears N. 75° E., 70.4 ft. dist., mkd. X BO on South vertical face.  
An immovable basalt stone, 30 ins. x 18 ins. x 12 ins. bears S. 60° W., 87.8 ft. dist., mkd. X BO on South half of North sloping face.

Set a steel fence post 5 ft. South of the monument and attached a 54-9 sign. Used a steel tape and staff compass with 18 1/2° declination for measurements to the BO's. Painted the bearing objects red.

This corner was remonumented to USFS specifications on Dec. 1, 1986, witnessed by Tom Fisk and Larry McBroom.

Office of... County Surveyor..... County of... Baker  
State of... Oregon..... I hereby certify that the within instrument was filed in this office  
for record on the..... day of....., 19.....  
..... by .....  
(COUNTY OFFICIAL) (DEPUTY)

Form R6-7100-57 (9/71)

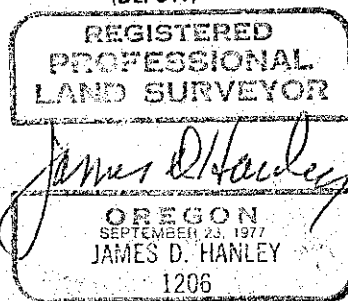

☆ GPO-798-276

FILED 10/18/88  
 BAKER COUNTY SURVEYOR  
 SURVEY NO. 7-43-195  
 7-42-16