

CERTIFIED RECORD OF LAND CORNER MONUMENTATION


T-13

History of original corner establishment:

W. B. Barr conducted the survey of Township 7 South, Range 43 East, W.M., August 29 to September 8, 1881, under GLO Contract No. 388, dated May 7, 1881.

The original notes of that survey relative to this corner state the following:

Marked basalt rock 28 in. x 10 in. x 4 in. for 1/4 sec. corner. Raised mound of rock as per instructions.

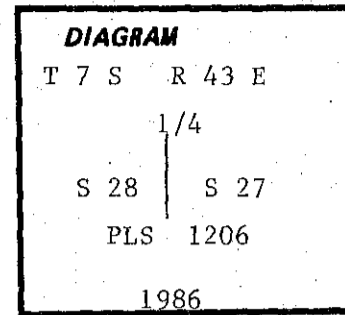

Description of corner evidence found:

A basalt stone, 8 ins. x 8 ins. x 24 ins. in a small stone mound, marked with faint 1/4 on face, lying face up.

Description of monument and accessories I established to perpetuate the original location of this corner: At the point of recovered corner stone:

Set a 2½ in. x 30 in. alum. pipe with a 2½ in. alum. cap 18 ins. into the ground. Constructed a 36 ins. diam. stone mound around the monument. The cap is marked as shown in the corner diagram. Buried the original corner stone 1 ft. North of monument. From the corner point:

A rock outcrop, 4 ft. x 12 ft. x 2 ft. high, bears N. 58° E., 9.6 ft. dist., mkd. X BO on Southeast face of stone.


A rock outcrop, 4 ft. x 6 ft. x 1 ft. high, bears N. 56° W., 13.2 ft. dist., mkd. X BO on top of stone.

Set a steel fence post 4 ft. West of the monument and attached a USFS 54-9 sign. Used a steel tape and staff compass set with 18½° declination for measurements to X on bearing objects. Painted the X BO's red.

This corner was remonumented to USFS specifications on Dec. 5, 1986, witnessed by Tom Fisk and Larry McBroom.

Office of.....County Surveyor.....County of...Baker.....
State of.....Oregon....., I hereby certify that the within instrument was filed in this office
for record on the..... day of....., 19.....
..... by
(COUNTY OFFICIAL) (DEPUTY)

Form R6-7100-57 (9/71)

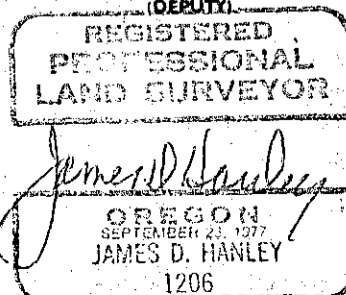

★ GPO—788-878

FILED 10/18/88
BAKER COUNTY SURVEYOR
SURVEY NO. 7-43-196