


CERTIFIED RECORD OF LAND CORNER MONUMENTATION

V-5

History of original corner establishment:

W. B. Barr conducted the survey of Township 7 South, Range 43 East, W.M., August 29 to September 8, 1881, under GLO Contract No. 388, dated May 7, 1881.

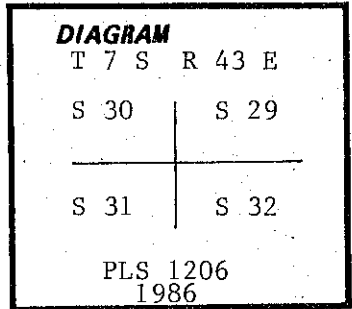

The original notes of that survey relative to this corner state the following:

Marked a volcanic rock 20 ins. x 12 ins. x 10 ins. for corner to sections 29, 30, 31 and 32. Raised mound of rock as per instructions.

Description of corner evidence found:

Found a faintly marked basalt stone in ancient stone mound. Stone measured 24 ins. x 12 ins. x 12 ins. with one groove on one side, and lying over in the mound.

Description of monument and accessories | established to perpetuate the original location of this corner:

At the point of the recovered stone:

Set a 2½ in. x 30 in. alum. pipe with a 2½ in. alum. cap 18 ins. into the ground. Constructed a 36 ins. diam. stone mound around the monument. The cap is marked as shown in the corner diagram. Deposited original stone 1 ft. North of monument. From the corner point:


- A 30 in. x 24 in. x 16 in. stone bears N. 51° E., 40.7 ft. dist., mkd. X BO on SW face.
- A 36 in. x 24 in. x 18 in. stone bears S. 25° E., 60.2 ft. dist., mkd. X BO on NW face.
- A 30 in. x 30 in. x 24 in. stone bears S. 58° W., 33.7 ft. dist., mkd. X BO on top.
- A 22 in. x 22 in. x 12 in. stone bears N. 81° W., 6.3 ft. dist., mkd. X BO on SE face.

Set a steel fence post 4 ft. North of the monument and attached a USFS 54-9 sign. Used a steel tape and staff compass set with 18½° declination for measurements to X on bearing objects. Painted the X BO's red.

This corner was remonumented to USFS specifications on Oct. 30, 1986, witnessed by Tom Fisk and Larry McBroom.

Office of..... County Surveyor..... County of... Baker.....
 State of..... Oregon..... I hereby certify that the within instrument was filed in this office
 for record on the..... day of....., 19.....
 by
 (COUNTY OFFICIAL) (DEPUTY)

Form R6-7100-57 (9/71)

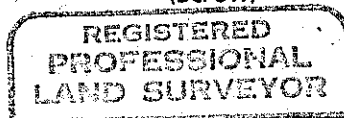

James D. Hanley
 OREGON
 SEPTEMBER 23, 1977
 JAMES D. HANLEY
 1206

★ GPO—700-476

FILED 10/18/88
 BAKER COUNTY SURVEYOR
 SURVEY NO. 7-43-199