

CERTIFIED RECORD OF LAND CORNER MONUMENTATION


V-11

History of original corner establishment:

W. B. Barr conducted the survey of Township 7 South, Range 43 East, W.M., August 29 to September 8, 1881, under GLO Contract No. 388, dated May 7, 1881.

The original notes of that survey relative to this corner state the following:

Marked basalt stone 30 ins. x 18 ins. x 10 ins. for 1/4 sec. corner. Raised a mound of stone as per instructions.

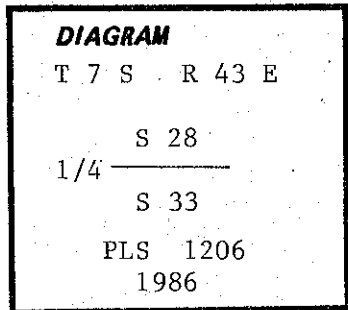

Description of corner evidence found:

Basalt stone, 7 in. x 17 in. x 29 in. in an obscure mound, mkd. with a faint 1/4 on face. Stone was lying face up in the mound.

Description of monument and accessories established to perpetuate the original location of this corner: At the point of recovered stone:

Set a 2 1/2 in. x 30 in. alum. pipe with a 2 1/2 in. alum. cap 16 ins. into the ground. Constructed a 36 ins. diam. stone mound around the monument. The cap is marked as shown in the corner diagram.

From the corner point:

A basalt stone, 3 ft. x 3 ft. x 2 ft. high bears S. 76° W., 129.4 ft. dist., mkd. X BO on top of stone.


A basalt stone, 5 ft. x 5 ft. x 2 ft. high bears N. 22° W., 94.8 ft. dist., mkd.. X BO on top of stone.

Set a steel fence post 4 ft. North of the monument and attached a USFS 54-9 sign. Used a steel tape and staff compass set with 18 1/2° declination for measurements to X on bearing objects. Painted the X BO's red.

This corner was remonumented to USFS specifications on Dec. 5, 1986, witnessed by Tom Fisk and Larry McBroom.

Office of... County Surveyor..... County of... Baker
State of... Oregon..... I hereby certify that the within instrument was filed in this office
for record on the..... day of....., 19.....
..... by
(COUNTY OFFICIAL)

Form R6-7100-57 (9/71)

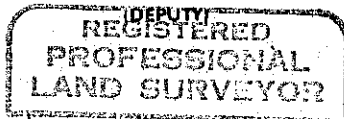

James D. Hanley
OREGON
SEPTEMBER 23, 1977
JAMES D. HANLEY
1206

☆ GPO-788-278

FILED 10/18/88
BAKER COUNTY SURVEYOR
SURVEY NO. 7-42-201