

CERTIFIED RECORD OF LAND CORNER MONUMENTATION


V-13

History of original corner establishment:

W. B. Barr conducted the survey of Township 7 South, Range 43 East, W.M., August 29 to September 8, 1881, under GLO Contract No. 388, dated May 7, 1881.

The original notes of that survey relative to this corner state the following:

Marked a basalt rock 12 ins. x 10 ins. x 5 ins. for corner to sections 27, 28, 33 and 34. Raised a mound of rock as per instructions.

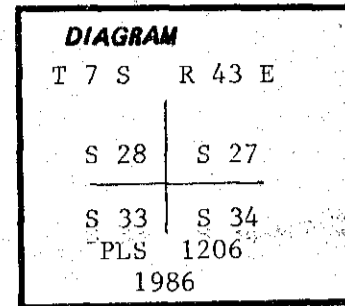

Description of corner evidence found:

Accepted ancient fence corner as the best evidence of the original corner point, which was only remaining evidence.

Description of monument and accessories established to perpetuate the original location of this corner:

At the ancient fence corner:

Set a 2½ in. x 30 in. alum. pipe with a 2½ in. alum cap 24 ins. into the ground. Constructed a 36 in. diam. stone mound around the monument. The cap is marked as shown in the corner diagram.

From the corner point:

- A stone, 3 ft. x 3 ft. x 6 in. above ground bears N. 45° E., 146.7 ft. dist., mkd. X BO on top of SE side of stone.
- A stone, 18 ins. x 18 ins. x 6 ins. above the ground bears S. 23° E., 114.0 ft. dist., mkd. X BO on top.
- A stone, 18 ins. x 18 ins. x 18 ins. above the ground, bears S. 86° W., 65.0 ft. dist., mkd. X BO on top.
- A stone, 30 ins. x 24 ins. x 12 ins. above the ground, bears N. 69° W., 58.2 ft. dist., mkd. X BO on top.

Set a steel fence post 4 ft. West from the monument and attached a USFS 54-9 sign. Used a steel tape and staff compass set with 18½° declination for measurement to X BO on the bearing objects. Painted the X BO's red.

This corner was remonumented to USFS specifications on Dec. 5, 1986, witnessed by Tom Fisk and Larry McBroom.


Office of County Surveyor County of Baker

State of Oregon, I hereby certify that the within instrument was filed in this office for record on the day of, 19.....

..... by

(COUNTY OFFICIAL) (DEPUTY)

Form R6-7100-57 (9/71)

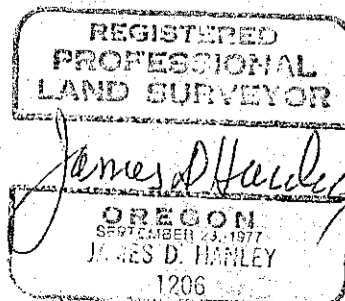

★ GPO—788-276

FILED 10/18/88

BAKER COUNTY SURVEYOR

SURVEY NO. 7-43-202