

DEPENDENT RESURVEY AND SECTION SUBDIVISION

SECTIONS 7, 8, 17, 18, 19, 20 T.7S., R.43E., W.M.


CORNER SEARCH BY SURVEY

SECTIONS 28, 29, 30 T.7S., R.43E., W.M.

SURVEY NARRATIVE

This survey was made under contract with the U.S. Forest Service for original corner search by survey traverse, monumentation of found corners and computed interior subdivisional corners and marking certain property ownership lines in Sections 7, 8, 17, 18, 19, 20 in T.7S., R.43E., W.M. for the purpose of establishing the record boundaries between US(FS) & private lands. Documentation of corner search records and records of corner monumentation are contained in the filed certified records accompanying this plat of survey. This survey was made by closed traverse using a Kern Model DEMAE one-second theodolite and a Hewlett Packard Model 3805 EDM.

Meridian by Solar Observations
Field Book 1, Page 1
Declination = 20° EAST

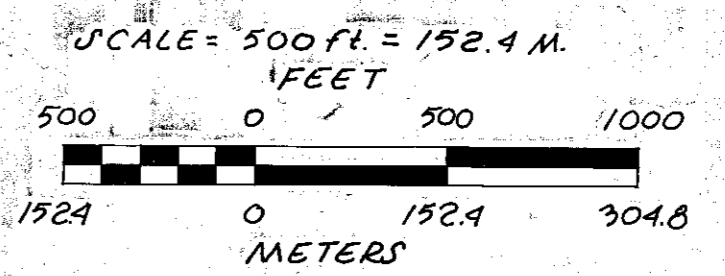

LEGEND

- Corner monumentation by others
- Corner and/or accessories found; set 2 1/2" diam. aluminum cap on 2 1/2" aluminum pipe.
- Set 2 1/2" diam. aluminum cap on 2 1/2" aluminum pipe, this survey.
- () Record bearing and distance, GLO surveys.
- Posted boundary lines between US and private lands.
- - - Section subdivision line.
- · - · - Approximate section line, not surveyed.

NOTE:
The U.S. Forest Service alpha-numeric method of corner referencing is shown on the North and West edges of this drawing.

SURVEY CERTIFICATE

I James D. Hanley, a registered Land Surveyor in the State of Oregon, hereby certify that this plat and the notes hereon, or referred thereto, are a correct representation of a survey performed under my supervision during 1986 and 1987, for the U.S. Forest Service in accordance with the statutes of the State of Oregon and the articles of my contract. This certification, made at the request of the U.S.D.A., Forest Service, applies to each of the two sheets comprising this survey data.

James D. Hanley, PLS
Oregon No. 1206
Nov. 4, 1987

HISTORY OF LAND SURVEYS IN T.7S., R.43E., W.M.

The history of surveys of the area represented on this Record of Survey are as follows:
The original survey of T.7S., R.43E., W.M., exterior and subdivisional lines was conducted by W.B. Barr under GLO Contract No. 388, dated May 7, 1881.
Corners in T.7S., R.43E., W.M., indicated by plat symbol ■ were monumented by the following surveyors:
Baker County Surveyor : E-3, 1985
Duane Farringer : G-9, 1986
Carl Sundet : N-1, N-7, N-9, P-9, R-11, all in 1987
N-5, 1982

**RECORD OF SURVEY
FOR
U.S. FOREST SERVICE
BALM CADASTRAL**
IN T.7S., R.43E., W.M., Baker Co., Oregon
BY HANLEY ENGINEERING, Baker, Oregon
CONTRACT NO. 53-04HI-6-0057N
1986-1987

SHEET 1 of 2

FILED 1-11-89
BAKER COUNTY SURVEYOR
SURVEY NO. 7-43-204

