

CERTIFIED RECORD OF LAND CORNER MONUMENTATION


History of original corner establishment:

Corner was established in 1887 by Henery W. Cook as a mineral Surveyor.

Set was a post 4in. x 4 feet in a mound of stone, marked Cor. No. 1 B.M.C. Sur. 11 from which:

A pine 48 in. dia. bears S 18 E, 21 ft, marked Cor. No. 1, BMC Sur. No. 11, BT.

A fir 24 in. dia bears East 19.5 ft, marked Cor. No. 1, BMC Sur. No. 11, BT.

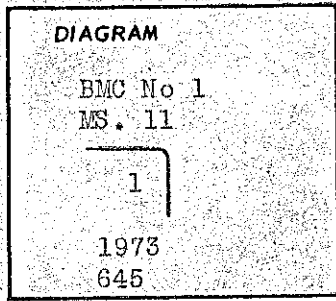

Description of corner evidence found:

At corner location I found a mound of stone, no evidence of any post, from which I found a dead pine standing that fit the description. This surveyor scribed in the bark and therefore was unable to find scribing as bark has fallen of the tree. Also I found a 30 in. fir with faint scribing on the bark.

Description of monument and accessories I established to perpetuate the original location of this corner

As the evidence agrees with the original survey, I set a 36 in. long, 2 in. galv. iron pipe with 2 in. brass cap in the ground with a mound of stone. Cap marked as shown in the diagram.

New bearing trees:

A pine 22 in. dia. bears S 46 E, 31.7 feet scribed BMC No 1 BT.

A pine 8 in. dia. bears S 11 E, 24.7 feet scribed BMC No 1 BT.

REGISTERED
PROFESSIONAL
LAND SURVEYOR

James H. Hambleton
10-10-73

OREGON
JULY 10, 1964
JAMES H. HAMBLETON
645

Office of County Surveyor County of Baker
State of Oregon, I hereby certify that the within instrument was filed in this office
for record on the 14 day of December, 1973, at 9:15 o'clock A.m., (signed)
by Tammy Hambleton
(COUNTY OFFICIAL) (DEPUTY)

SURVEY NO. 7-44-2