


**CERTIFIED RECORD OF LAND CORNER MONUMENTATION**

**History of original corner establishment:**

Corner was established in 1887 by Henry W. Cook as a deputy Mineral Surveyor.

Set was a post 4.5 ft. long 4 in. sq. in a mound of stone, marked Cor. No. 2. BMC Sur. No. 11 from which:

A fir 10 in. dia. bears S 72 E, 25 feet, marked Cor. No. 2 BMC Sur No 11 Bt.

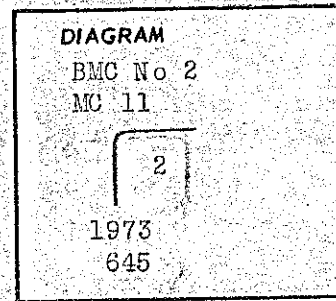

**Description of corner evidence found:**

At corner location I found a fir 24 in. dia. with scribing on the bark legible enough to make out Cor 2 BMC Sur No 11 Bt.

No other evidence available as hillside is very steep.

**Description of monument and accessories I established to perpetuate the original location of this corner**

As the BT agrees with the original survey noted, I relocated the corner in its original position. I set a 30 in. galv. iron pipe 2 in. in dia. with a 2 in. brass cap marked as shown in the diagram.

**New bearing tree:**

A red fir 12 in. dia. bears N 15 W, 37.8 ft. scribed BMC No 2 Bt.

REGISTERED  
 PROFESSIONAL  
 LAND SURVEYOR

*James H. Hambleton*  
 10-10-73

OREGON  
 JULY 10, 1967  
 JAMES H. HAMBLETON  
 645

Office of *County Surveyor* County of *Baker*  
 State of *Oregon*, I hereby certify that the within instrument was filed in this office  
 for record on the *14* day of *December*, 19*73*, at *9:15* o'clock *A.*m., (signed)  
 by *Tom Hanley*  
 (COUNTY OFFICIAL) (DEPUTY)

SURVEY NO. 7-44-3