


P-9160-2
Nov. 1964

UNITED STATES
DEPARTMENT OF THE INTERIOR
BUREAU OF LAND MANAGEMENT

TOWNSHIP DIAGRAM

SCALE: 1 INCH = 1 MILE

TOWNSHIP 7 South, RANGE 44 East, Willamette MER.
STATE Oregon

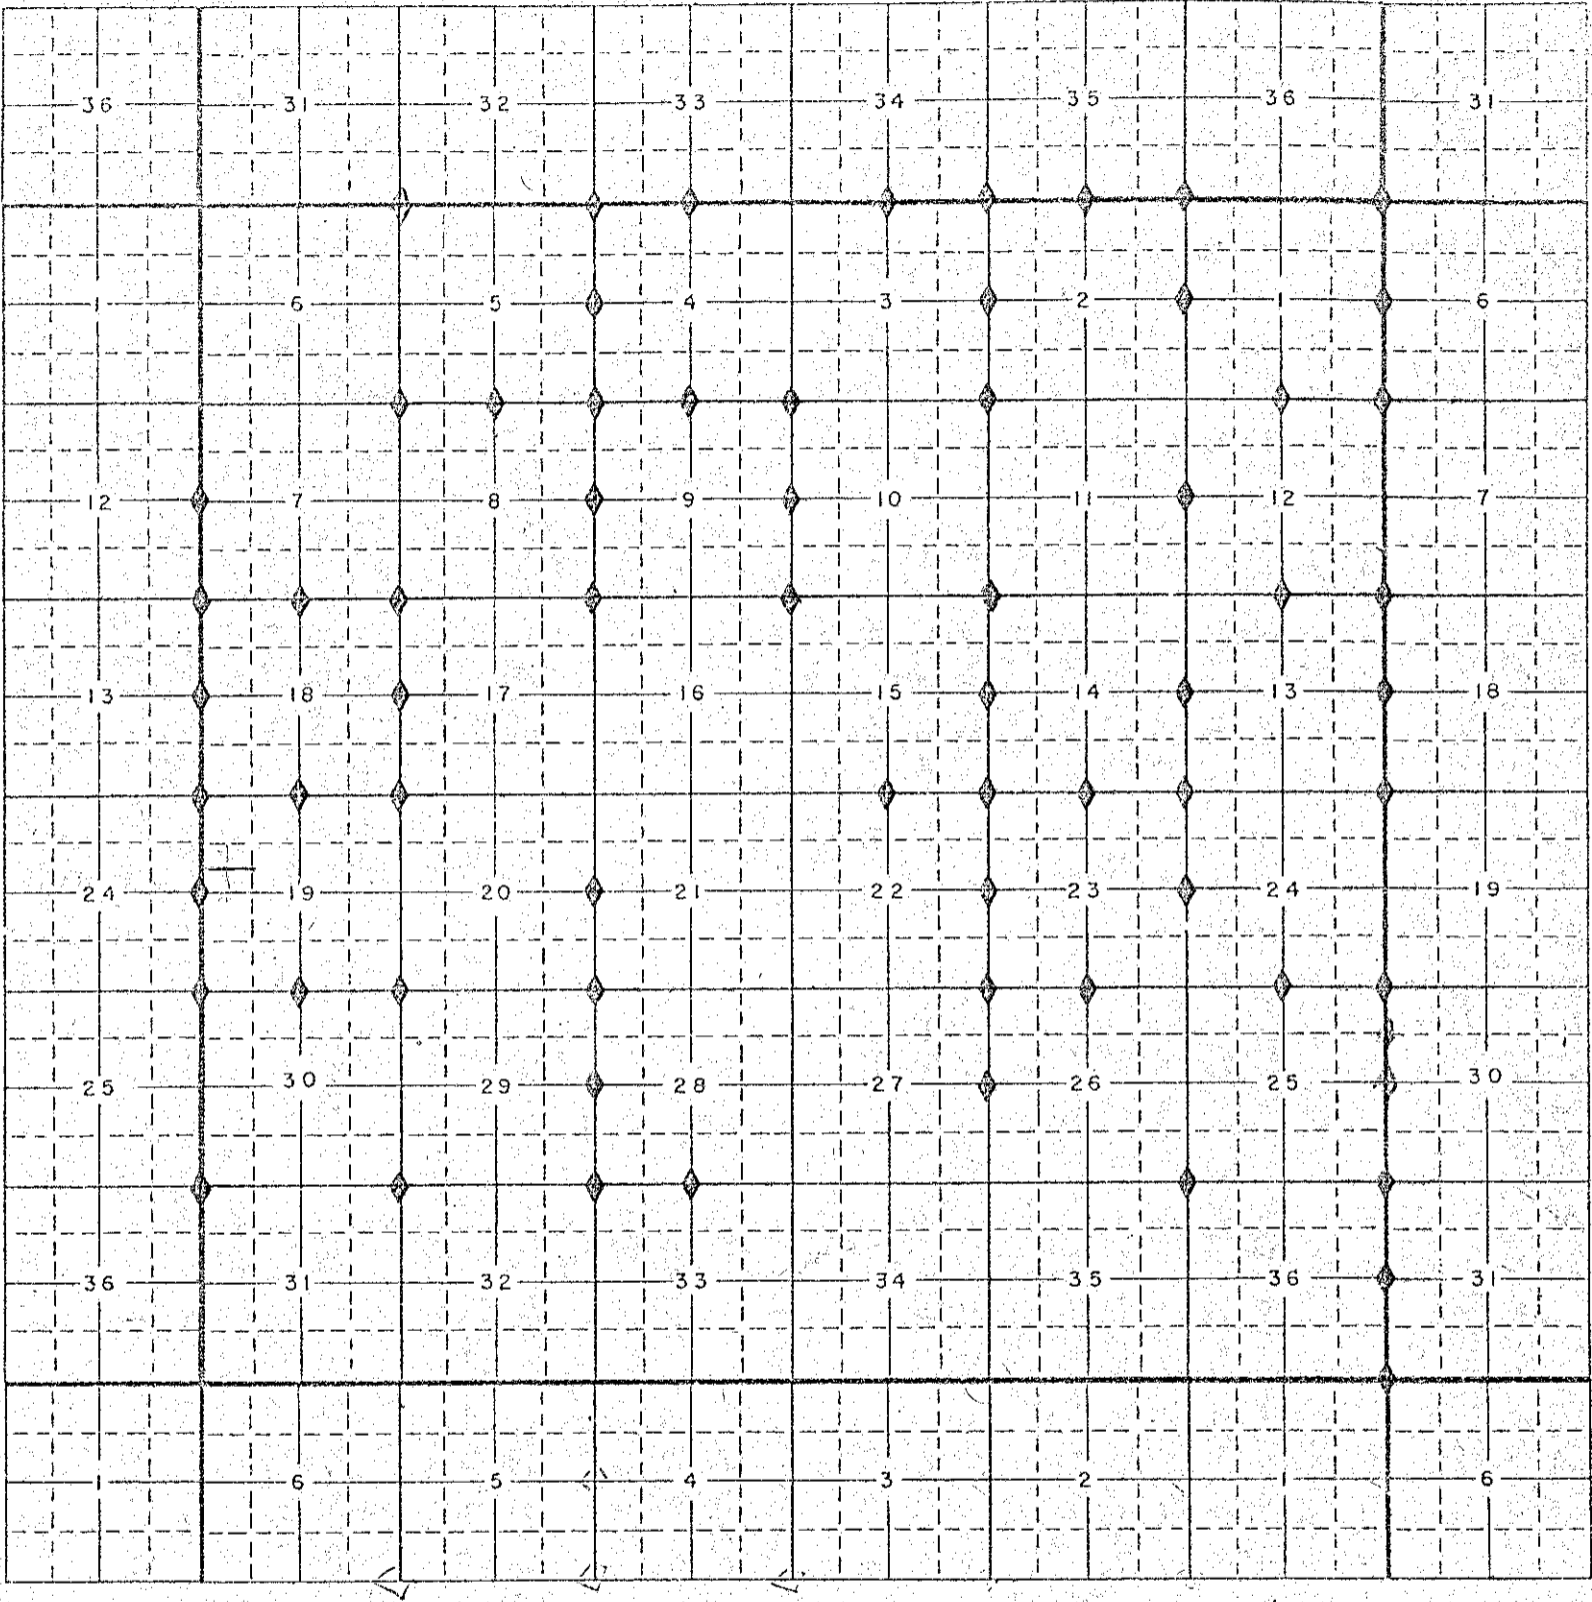

Baker County

Wallowa-Whitman National Forest, Region 6

◊ Corners Remonumented

FILED Nov. 18, 1974

BAKER COUNTY SURVEYOR

SURVEY NO. 7-44-6