

CERTIFIED RECORD OF LAND CORNER MONUMENTATION


History of original corner establishment:

Corner established by Gordon C. Smith, under instructions dated January 13, 1940, for mineral survey #867.

Set a 1"x36" galvanized iron pipe 28" in ground, marked "M3-867" from which;

a pine 16" in diameter bears S 15° E 45.5 feet distance, marked "M3-867 BT"

a pine 16" in diameter bears S 81° W 33.7 feet distance, marked "M3-867 BT"

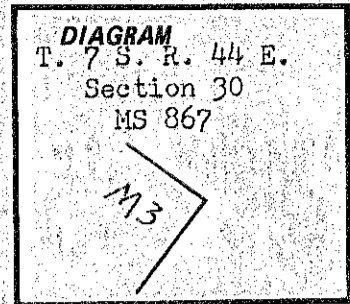

Description of corner evidence found:

Found 2 1/2" galvanized iron pipe with 2 1/2" brass cap set 2" below ground. No markings on cap. Cap is .75 feet northeast of corner location.

Found ^{18"} ponderosa pine S 84° W 33.7 feet distance, alive with open face, scribed "M3-867 BT"

Found badly decayed pine stump with no visible scribing S 14° E 45.5 feet distance.

Found 1" galvanized iron pipe S 87° E 82.8 feet distance marked "M3 867" from corner position.

Distances are to side and center of bearing trees.

Description of monument and accessories established to perpetuate the original location of this corner:


Set 2 1/2"x30" aluminum pipe with 3/4" aluminum cap 26" in ground in mound of stone. Buried original pipe alongside of new monument. Cap marked;

Bearing trees

a ponderosa pine 10" in diameter bears S 34° E 17.0 feet distance, scribed "M3MS867" in upper blaze and "BT" and brass tag stamped RLS 1664 in lower blaze.

a ponderosa pine 9" in diameter bears N 10° W 21.8 feet distance, scribed "M3MS867" in upper blaze and "BT" and brass tag stamped RLS 1664 in lower blaze.

Compass declination 20° East

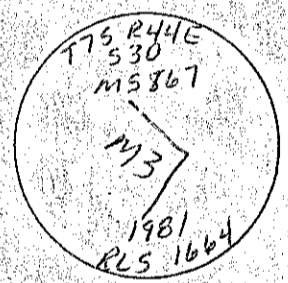

Note

I set a steel fence post with USFS Attention sign at corner, placed USFS 54-8 signs on all bearing trees, and painted red band on smooth bark at breast height on all bearing trees,

I hereby certify the above corner location was perpetuated as herein described on September 20, 1981.

Terry Butler, Witness

Frank Vaughn Frank Vaughn, Witness

REGISTERED
PROFESSIONAL
LAND SURVEYOR

Carl E. Sundet

OREGON
JULY 14, 1978
CARL E. SUNDET
1664

Office of..... County of.....

State of....., I hereby certify that the within instrument was filed in this office

for record on the..... day of....., 19....

..... by

(COUNTY OFFICIAL)

(DEPUTY)