


CERTIFIED RECORD OF LAND CORNER MONUMENTATION

History of original corner establishment:

Corner originally established by W.B. Barr under contract #503, dated May 23, 1884.

- Set 26"x10"x6" stone from which;
- a pine 36" diameter bears S 39° W 54 links
- a pine 36" diameter bears N 62° W 75 links

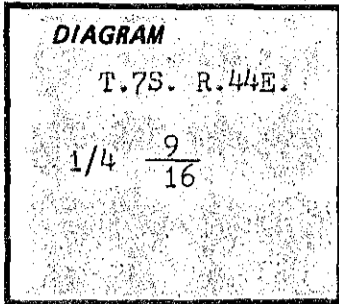

Description of corner evidence found:

No evidence of stone.

Bearing Trees

- 38" P.Pine snag, S. 39° W 54 links, scribed "1/4 S" "BT"
- No evidence of NW BT.

Description of monument and accessories established to perpetuate the original location of this corner:

Set 2 1/2"x30" aluminum pipe with 3 1/4" aluminum cap 6" in ground to bedrock in allarge mound of stone. Cap marked;

Bearing Trees

- 6" Douglas Fir bears N 04° E 40.2 ft., scribed "1/4 S9" in upper blaze and "BT" and brass tag stamped RLS 1664 in lower blaze.
- 7" Douglas Fir bears S 19° W 68.9 ft., scribed "1/4 S16" in upper blaze and "BT" and brass tag stamped RLS 1664 in lower blaze.

Compass declination 21° East.

Note:

I set steel fence post at corner with USFS attention sign, placed USFS bearing tree signs on all bearing trees, and painted red band on smooth bark at breast height on all bearing trees.

I hereby certify the above corner was perpetuated as herein described in August 1981.

Terry Butler Terry Butler, Witness
Frank Vaughn Frank Vaughn, Witness



REGISTERED
PROFESSIONAL
LAND SURVEYOR

Carl E. Sundet
 OREGON
 JULY 14, 1978
 CARL E. SUNDET
 1664

Office of..... County of.....
 State of..... I hereby certify that the within instrument was filed in this office
 for record on the..... day of....., 19.....
 by.....
 (COUNTY OFFICIAL) (DEPUTY)

Form R6-7100-57 (9/71)

FILED Oct 22, 1981
 BAKER COUNTY SURVEYOR
 SURVEY NO. 7-44-17