


CERTIFIED RECORD OF LAND CORNER MONUMENTATION

History of original corner establishment:

Corner originally established by W.B. Earr under contract #503, dated May 23, 1884.  
Set basalt rock 18"x12"x7" 12 inches in ground from which;  
a pine 24" diameter bears N 57°W 45 links  
a fir 16" diameter bears S 45°E 60 links

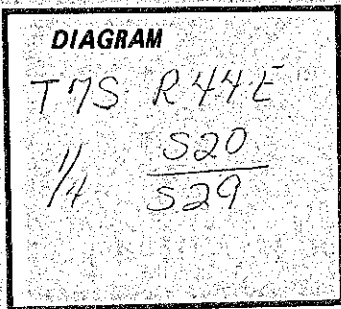

Description of corner evidence found:  
No evidence of original stone.

Found  
douglas fir - dead and down - rotten - S36½°E  
60 lks - scribed "BT"  
22" P. Pine stump - N 61°W 45 lks - no scribing  
visible - partly rotten

Description of monument and accessories I established to perpetuate the original location of this corner:  
Set 2½" x 30" aluminum pipe with 3¼" aluminum cap 26" in ground in mound of stone, marked;



Bearing trees:  
8" ponderosa pine - N77½°E - 22.5 ft. - scribed "¼ S20" in upper blaze and "BT" and brass tag stamped RLS 1664 in lower blaze  
13" ponderosa pine - S25°W - 61.3 ft. - scribed "¼ S29" in upper blaze and "BT" and brass tag stamped RLS 1664 in lower blaze

Compass declination 20° East

Note:  
I set steel fence post at corner location with USFS Attention sign, placed USFS bearing tree signs on all bearing trees and painted red band on smoothed bark at breast height on all bearing trees.

I hereby certify the above corner location was perpetuated as herein described in August 1981.

Terry Butler Terry Butler, Witness  
Frank Vaughn Frank Vaughn, Witness

REGISTERED  
PROFESSIONAL  
LAND SURVEYOR

Carl E. Sundet  
OREGON  
JULY 14, 1978  
CARL E. SUNDET  
1664

Office of..... County of.....  
State of..... I hereby certify that the within instrument was filed in this office  
for record on the..... day of....., 19.....  
..... by .....

(COUNTY OFFICIAL)

(DEPUTY)