


CERTIFIED RECORD OF LAND CORNER MONUMENTATION

History of original corner establishment:

Corner originally established by W.B. Barr under contract #503, dated May 23, 1884.
Set andstone 16"x10"x6" 11 inches in ground from which;
a fir 8" diameter bears N 72° W 14 links
a pine 48" diameter bears S 54° E 6 links

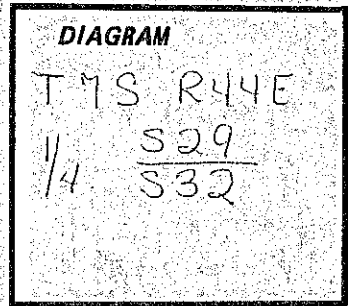

Description of corner evidence found:

Found 16" x 10" x 6" stone with 1/4 on north face.

Bearing tree:

48" ponderosa pine - dead and down - rotten - N54° E
6 lks - no visible scribing.
NW BT Gone


Description of monument and accessories established to perpetuate the original location of this corner:

Set 2 1/2" x 30" aluminum pipe with 3 1/4" aluminum cap 24" in ground in mound of stone, marked:
Buried original stone alongside pipe.

Bearing trees;

8" ponderosa pine - N20° E - 41.9 ft. - scribed "1/4 S 29" in upper blaze and "BT" and brass tag stamped RLS 1664 in lower blaze
13" ponderosa pine - S15 1/2° E - 8.9 ft. - scribed "1/4 S 32" in upper blaze and "BT" and brass tag stamped RLS 1664 in lower blaze

Compass declination 20° 15' East

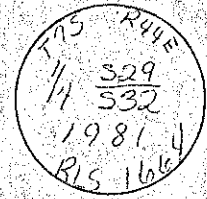

Note:

I set steel fence post at corner location with USFS attention sign, placed USFS bearing tree signs on all bearing trees and painted red band on smooth bark at breast height on all bearing trees.

I hereby certify the above corner location was perpetuated as herein described in August 1981.

REGISTERED
PROFESSIONAL
LAND SURVEYOR

Terry Butler Terry Butler, Witness

Frank Vaughn Frank Vaughn, Witness

Carl E. Sundet

OREGON
JULY 14, 1978
CARL E. SUNDET
1664

Office of..... County of.....

State of....., I hereby certify that the within instrument was filed in this office

for record on the..... day of....., 19....

..... by

(COUNTY OFFICIAL)

(DEPUTY)

Form R6-7100-57 (9/71)

FILED Oct 27, 1981
BAKER COUNTY SURVEYOR
SURVEY NO. 7-44-20