


CERTIFIED RECORD OF LAND CORNER MONUMENTATION

History of original corner establishment:

Corner originally established by W.B. Barr under contract #503, dated May 23, 1884.
Set basalt rock 15 in. x 12 in. x 10 in. 10 in. in ground from which:
a pine 36 in. diameter bears N 08°W 22 links
a pine 40 in. diameter bears N 10°E 56 links

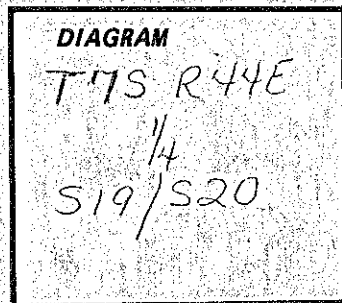

Description of corner evidence found:

Found 15" x 12" x 10" stone marked 1/4

Bearing trees:

Ponderosa pine - high stump with scribed face lying at base - N08°E - 41 lks
Ponderosa pine - rotten stump - N01°W - 22 lks - no visible scribing

Description of monument and accessories established to perpetuate the original location of this corner:

Set 2 1/2" x 30" aluminum pipe with 3 1/4" aluminum cap 24" in ground in mound of stone, marked:
Buried broken brown glass and original stone alongside pipe.



Bearing trees:

10" ponderosa pine - N09°W - 74.3 ft. - scribed "1/4 S19" in upper blaze and "ET" and brass tag stamped RLS 1664 in lower blaze.
9" ponderosa pine - N81°E - 31.8 ft. - scribed "1/4 S20" in upper blaze and "EF" and brass tag stamped RLS 1664 in lower blaze.

Compass declination 20°20' East

Note:

I set steel fence post at corner with USFS attention sign, placed USFS bearing tree signs on all bearing trees and painted red band on smooth bark at breast height on all bearing trees.

I hereby certify the above corner was perpetuated as herein described in August 1981.

REGISTERED
PROFESSIONAL
LAND SURVEYOR

Carl E. Sundet

OREGON
JULY 14, 1978
CARL E. SUNDET
1664

Terry Eutler Terry Eutler, Witness

Frank Vaughn Frank Vaughn, Witness

Office of..... County of.....
State of..... I hereby certify that the within instrument was filed in this office
for record on the..... day of....., 19.....
..... by

(COUNTY OFFICIAL)

(DEPUTY)