


CERTIFIED RECORD OF LAND CORNER MONUMENTATION

History of original corner establishment:

Corner originally established by W. Barr contract # 388, dated May 7, 1881
Set basalt stone 15" x 12" x 6" from which;
a pine 24" in diameter bears N49½°E - 35 lks
a pine 30" in diameter bears S71°W - 35 lks

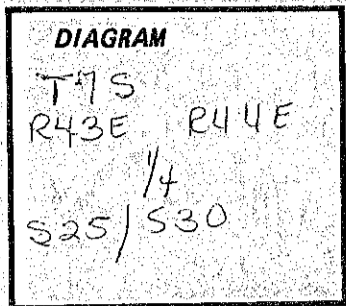


Description of corner evidence found:

Found 15" x 12" x 6" stone, out of position, scribed "¼"
Found:
28" ponderosa pine stump - N57°E - 35 lks - scribed "BT", partially rotten
18" ponderosa pine stump - S71°W - 35 lks - scribed "BT", partially rotten

Description of monument and accessories I established to perpetuate the original location of this corner:

Set 2½" x 30" aluminum pipe with 3¼" aluminum cap 24" in ground in mound of stone, marked:
Buried original stone alongside pipe.
Bearing trees:
12" ponderosa pine - S63°W - 26.0 ft. - scribed "¼ S25" in upper blaze and "BT" and brass tag stamped RLS 1664 in lower blaze
9" ponderosa pine - N28½°E - 38.1 ft. - scribed "¼ S30" in upper blaze and "BT" and brass tag stamped RLS 1664 in lower blaze

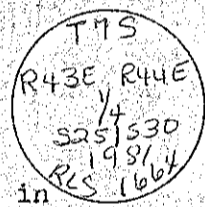

Compass declination 21¼° East

Note:

I set steel fence post at corner with USFS Attention sign, placed USFS bearing tree signs on all bearing trees and painted red band on smooth bark at breast height on all bearing trees,

I hereby certify the above corner location was perpetuated as herein described in August 1981

REGISTERED
PROFESSIONAL
LAND SURVEYOR
Carl E. Sundet
OREGON
JULY 14, 1978
CARL E. SUNDET
1664

Terry Butler Terry Butler, Witness
Frank Vaughn Frank Vaughn, Witness

Office of..... County of.....
State of....., I hereby certify that the within instrument was filed in this office
for record on the..... day of....., 19.....
..... by

(COUNTY OFFICIAL) (DEPUTY)