


CERTIFIED RECORD OF LAND CORNER MONUMENTATION

History of original corner establishment:

Corner established by Gordon C. Smith, under instructions dated January 13, 1940, for mineral survey #867.

Set a 1" x 36" galvanized iron pipe 28" in ground marked "F1-867" from which;
a fir 10" in diameter bears S60°W a distance of 51.9 ft., marked "F1-867 BT"
a pine 10" in diameter bears S77°W a distance of 39 ft., marked "F1-867 BT"

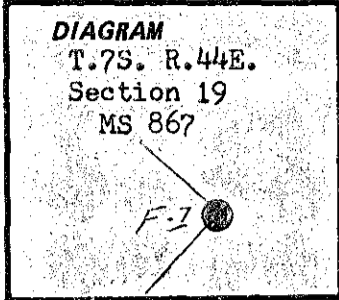

Description of corner evidence found:

Found 1" Galvanized iron pipe marked "F1 867"

Bearing trees;

18" fir - S64 1/2°W - 51.9 ft. - scribed 867 in partly chopped open face, tree is a 20 ft. snag.
19" ponderosa pine - S82°W - 39.0 ft., alive with healed face.

Distances to side and center of BT's

Description of monument and accessories established to perpetuate the original location of this corner:

Set 2 1/2" x 30" aluminum pipe with 3/4" aluminum cap 26" in ground in mound of stone, marked;
Buried original stone alongside new monument.



Bearing tree;

11" ponderosa pine - N26°E - 1.9 ft. - scribed "F1-MS867" in upper blaze and "BT" and brass tag stamped RLS 1664 in lower blaze

Compass declination 20°East

Note:

I set a steel fence post with USFS Attention sign at corner, placed USFS 54-8 signs on all bearing trees and painted red band on smoothed bark at breast height on all bearing trees.

I hereby certify the above corner location was perpetuated as herein described October 27, 1981.

Terry Butler Terry Butler, Witness
Frank Vaughn Frank Vaughn, Witness

REGISTERED PROFESSIONAL LAND SURVEYOR

Carl E. Sundet
OREGON
JULY 14, 1978
CARL E. SUNDET
1664

Office of..... County of.....
State of..... I hereby certify that the within instrument was filed in this office for record on the..... day of....., 19.....
..... by
(COUNTY OFFICIAL) (DEPUTY)

Form R6-7100-57 (9/71)

FILED Nov. 9, 1981
BAKER COUNTY SURVEYOR
SURVEY NO. 7-44-24

GPO-798-276