


CERTIFIED RECORD OF LAND CORNER MONUMENTATION

History of original corner establishment:

Corner established by Gordon C. Smith, under instructions dated January 13, 1940, for mineral survey #867
Set a 1" x 36" galvanized iron pipe 28" in ground marked "M4-P2-867" from which;
a fir 8" in diameter bears S41°E a distance of 13.3 ft., marked "M4-P2-867 BT"
a fir 10" in diameter bears S15°W a distance of 4.5 ft., marked "M4-P2-867 BT"

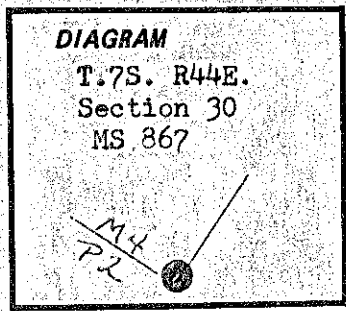

Description of corner evidence found:

Found 1" galvanized iron pipe marked "P2-M4" 2" above ground


Bearing trees;

- 21" fir - S13°W - healed face - alive - 4.5 ft.
- 18" fir - S37½°E - 13.3 ft. - alive - healed face

Distances to side and center of BT's

Description of monument and accessories established to perpetuate the original location of this corner:

Set 2½" x 30" aluminum pipe with 3¼" aluminum cap 26" in ground in mound of stone marked;
Buried original pipe alongside new monument.

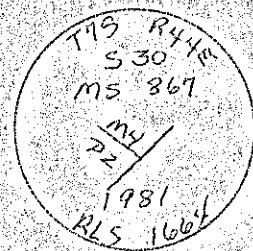

Note:

I set a steel fence post with USFS attention sign at corner, placed USFS 54-8 signs on all bearing trees and painted red band on smoothed bark at breast height on all bearing trees.

I hereby certify the above corner location was perpetuated as herein described October 27, 1981.

Terry Butler Terry Butler, Witness

Frank Vaughn Frank Vaughn, Witness

REGISTERED PROFESSIONAL LAND SURVEYOR

Carl E. Sundet
OREGON
JULY 14, 1978
CARL E. SUNDET
1664

Office of..... County of.....
State of..... I hereby certify that the within instrument was filed in this office for record on the..... day of....., 19.....
..... by

(COUNTY OFFICIAL)

(DEPUTY)