


CERTIFIED RECORD OF LAND CORNER MONUMENTATION

History of original corner establishment:

Corner originally established by C.M. Foster in December 1882 under instructions dated October 23, 1882.

Set post marked E.M.W. No. 3-126.

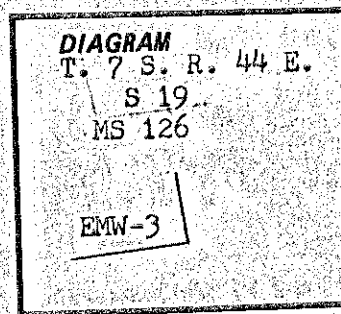

Description of corner evidence found:

Found remains of 4" x 4" scribed post. Scribed EMW, the rest was illegible. Post was in a mound of stone.

Description of monument and accessories established to perpetuate the original location of this corner: Set a 2 1/2" x 30" aluminum pipe with a 3 1/4" aluminum cap 14" in ground in mound of stone. Cap marked;

Bearing Trees

12" ponderosa pine, S 64° E, 66.4 ft., scribed "EMW3 MS 126" in upper blaze and "BT" and brass tag stamped RLS 1664 in lower blaze.

8" ponderosa pine, N 33° W, 21.3 ft., scribed "EMW3 MS 126" in upper blaze and "BT" and brass tag stamped RLS 1664 in lower blaze.

Compass declination 20° East

Note:

I set guard posts at corner with USFS 54-2 and 54-4 signs and placed USFS 54-4 and 54-8 signs and painted a red band on smoothed bark at breast height on bearing trees.

I hereby certify the above corner location was perpetuated as herein described on May 18, 1982.

Terry Butler Terry Butler, Witness

Frank Vaughn Frank Vaughn, Witness

REGISTERED
PROFESSIONAL
LAND SURVEYOR

Carl E. Sundet

OREGON
JULY 14, 1973
CARL E. SUNDET
1664

T 7 S R 44 E
S 19
MS 126
EMW-3
1982
RLS 1664

Office of..... County of.....
State of..... I hereby certify that the within instrument was filed in this office
for record on the..... day of....., 19.....
..... by
(COUNTY OFFICIAL) (DEPUTY)