

CERTIFIED RECORD OF LAND CORNER MONUMENTATION


History of original corner establishment:

Corner established by W. B. Barr under GLO contract no. 503, dated May 23, 1884.

Surveyor General records state:

Set limestone 20 x 12 x 6 ins 15 ins in the ground for 1/4 Sec Cor marked 1/4 on the N side from which:

A tamarack 6 ins diam bears S 17° W, 21 lks dist mkd 1/4 S BT  
A tamarack 4 ins diam bears N 27° E, 14 lks dist mkd 1/4 S BT

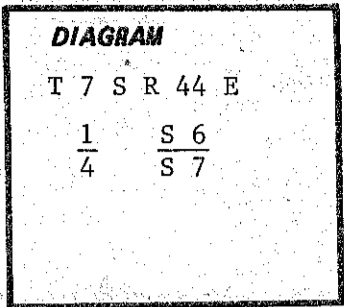

Description of corner evidence found:

This corner was searched for during the course of survey for Collins Pine Co. in 1977 and 1978, and again this date in location determined from survey between the adjacent section corners East and West. No trace was found of original stone or bearing trees.

NOTE: See Baker County Surveyor file number 7-44-34 for map of survey and narrative.

Description of monument and accessories established to perpetuate the original location of this corner:

At the position determined by single proportionate measurement along the South line of Section 6, set a 2½-inch brass cap on a 2-inch iron pipe, 31 inches long and projecting 6 inches out of the ground with a surrounding rock mound.

Brass cap marked thus: T 7 S R 44 E

$\frac{1}{4}$        $\frac{S 6}{S 7}$


1982

ORLS 1639

New bearing trees:

A fir 9 inches diam bears S 71° E, 28.2 feet dist marked 1/4 S 7 BT.  
A fir 9 inches diam bears N 61° E, 35.2 feet dist marked 1/4 S 6 BT.

I hereby certify that the above described corner monument was properly reestablished under my supervision on Oct. 4, 1982, and witnessed by Brad Gordon, Tom Fisk, and Jim DeMastus.

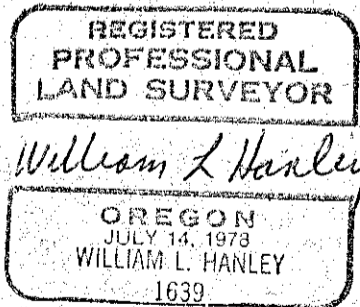

Office of..... County of.....  
State of....., I hereby certify that the within instrument was filed in this office  
for record on the..... day of....., 19.....  
..... by .....  
(COUNTY OFFICIAL) (DEPUTY)

Form R6-7100-57 (9/71)

FILED Oct 5, 1982  
BAKER COUNTY SURVEYOR  
SURVEY NO. 7-44-36