


CERTIFIED RECORD OF LAND CORNER MONUMENTATION

History of original corner establishment:

Corner originally established by Walden under contract #198, dated July 15, 1883
Set 14"x8"x5" granite stone 8" in ground.

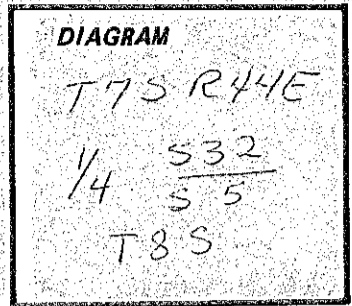

Description of corner evidence found:

Found 14"x8"x5" stone marked 1/4 on west face

Description of monument and accessories I established to perpetuate the original location of this corner:

Set 2 1/2" x 30" aluminum pipe with 3 1/4" aluminum cap 26" in ground in small mound of stone, marked;
Buried original stone alongside of pipe.



Bearing trees:

8" ponderosa pine - N32°W - 29.9 ft. scribed "1/4 S32" in upper blaze and "BT" and brass tag stamped RLS 1664 in lower blaze.

7" ponderosa pine - S11°W - 40.6 ft. scribed "1/4 S5" in upper blaze and "BT" and brass tag stamped RLS 1664 in lower blaze.

Compass declination 20° East

Note:

I set steel fence post 5' west of corner location with USFS attention sign, placed USFS bearing tree signs on all bearing trees and painted red band on smoothed bark at breast height on all bearing trees.

I hereby certify the above corner location was perpetuated as herein described in September 1982

Frank Vaughn Frank Vaughn, Witness

REGISTERED
PROFESSIONAL
LAND SURVEYOR

Carl E. Sundet

OREGON
JULY 14, 1978
CARL E. SUNDET
1664

Office of..... County of.....
State of..... I hereby certify that the within instrument was filed in this office
for record on the..... day of....., 19.....
..... by

(COUNTY OFFICIAL) (DEPUTY)