


CERTIFIED RECORD OF LAND CORNER MONUMENTATION

History of original corner establishment:

None

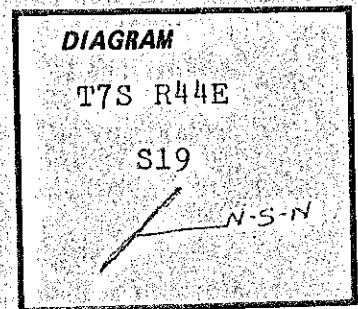


Description of corner evidence found:

None

Description of monument and accessories I established to perpetuate the original location of this corner:

Set 2½" x 30" aluminum pipe with ¾" aluminum cap 26" in ground, marked:
No stones available for mound.

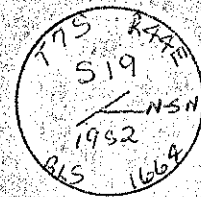

Bearing trees:

13" ponderosa pine - S63.5°W - 34.0 ft. scribed "X" in upper blaze and "BT" and brass tag stamped RLS 1664 in lower blaze
13" tamarack - S13°E - 48.3 ft. scribed "X" in upper blaze and "BT" and brass tag stamped RLS 1664 in lower blaze

Compass declination 20° East

Note:

I set steel fence post at corner location with USFS 54-9 sign, placed USFS bearing tree signs on all bearing trees and painted red band at breast height on smoothed bark on all bearing trees

I hereby certify the above corner was perpetuated as herein described in August 1982

REGISTERED
PROFESSIONAL
LAND SURVEYOR

Office of..... County of.....
State of..... I hereby certify that the within instrument was filed in this office
for record on the..... day of....., 19.....
..... by.....
(COUNTY OFFICIAL) (DEPUTY)

Carl E. Sundet
REGISTERED
PROFESSIONAL
LAND SURVEYOR
JULY 14, 1978
CARL E. SUNDET
1664