


CERTIFIED RECORD OF LAND CORNER MONUMENTATION

History of original corner establishment:

None

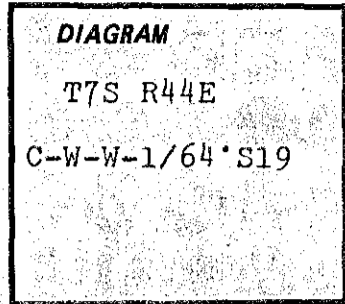

Description of corner evidence found:

None

Description of monument and accessories established to perpetuate the original location of this corner:

Set 2 1/2" x 30" aluminum pipe with 3/4" aluminum cap  
25" in ground, marked;  
No stones available for mound.



Bearing trees:

10" tamarack - N47°W - 42.5 ft. scribed "C-W-W-1/64 S19"  
in upper blaze and "BT" and brass tag stamped RLS 1664 in lower blaze  
10" ponderosa pine - N84 1/2°E - 28.7 ft. scribed "C-W-W-1/64 S19"  
in upper blaze and "BT" and brass tag stamped RLS 1664 in lower blaze  
Compass declination 20° East  
Found 3" red post - N29°W - 54.6 ft.

Note:

I set steel fence post at corner location with USFS 54-9 sign,  
placed USFS bearing tree signs on all bearing trees and painted  
red band at breast height on smoothed bark on all bearing trees.

I hereby certify the above corner location was perpetuated  
as herein described in August 1982.

REGISTERED  
PROFESSIONAL  
LAND SURVEYOR

*Carl E. Sundet*

OREGON  
JULY 14, 1978  
CARL E. SUNDET  
1664

Office of..... County of.....  
State of....., I hereby certify that the within instrument was filed in this office  
for record on the..... day of....., 19.....  
..... by .....  
(COUNTY OFFICIAL) (DEPUTY)

Form R6-7100-57 (9/71)

FILED Dec 20 1982  
BAKER COUNTY SURVEYOR  
SURVEY NO. 7-44-53

☆ GPO—798-276