


CERTIFIED RECORD OF LAND CORNER MONUMENTATION

History of original corner establishment:

None

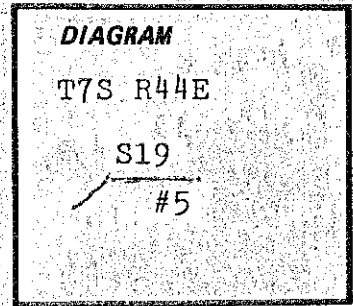

Description of corner evidence found:

None

Description of monument and accessories I established to perpetuate the original location of this corner:

Set 2½" x 30" aluminum pipe with ¾" aluminum cap 26" in ground in small mound of stone marked:

Bearing trees:

8" ponderosa pine - N18°E - 69.1 ft. scribed "#5 S19" in upper blaze and "BT" and brass tag stamped RLS 1664 in lower blaze
 7" ponderosa pine - N84.5°E - 28.3 ft. scribed "#5 S19" in upper blaze and "BT" and brass tag stamped RLS 1664 in lower blaze

Compass declination 20° East

Note:

I set steel fence post at corner location with USFS 54-9 sign, placed USFS bearing tree signs on all bearing trees and painted red band at breast height on smoothed bark on all bearing trees

I hereby certify the above corner was perpetuated as herein described in August 1982



Office of..... County of.....
 State of..... I hereby certify that the within instrument was filed in this office
 for record on the..... day of..... 19.....
 (COUNTY OFFICIAL) by (DEPUTY)

