


CERTIFIED RECORD OF LAND CORNER MONUMENTATION

History of original corner establishment:

None

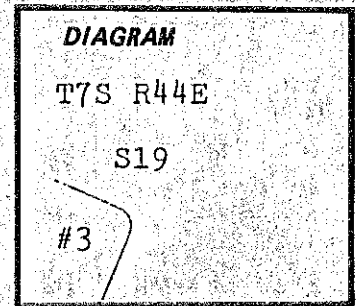

Description of corner evidence found:

None

Description of monument and accessories established to perpetuate the original location of this corner:

Set 2½" x 30" aluminum pipe with ¾" aluminum cap 26" in ground, marked:  
No stones available for mound.



Bearing trees:


15" ponderosa pine - S43°W - 70.0 ft. scribed "#3 S19" in upper blaze and "BT" and brass tag stamped RLS 1664 in lower blaze  
11" ponderosa pine - S77°E - 12.0 ft. scribed "#3 S19" in upper blaze and "BT" and brass tag stamped RLS 1664 in lower blaze

Compass declination 20° East

Note:

I set steel fence post at corner location with USFS 54-9 sign, placed USFS bearing tree signs on all bearing trees and painted red band at breast height on smoothed bark on all bearing trees.

I hereby certify the above corner was perpetuated as herein described in August 1982

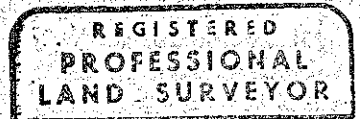

*Carl E. Sundet*



Office of..... County of.....

State of....., I hereby certify that the within instrument was filed in this office

for record on the..... day of....., 19.....

..... by .....

(COUNTY OFFICIAL)

(DEPUTY)

Form R6-7100-57 (9/71)

FILED Dec 20 1982  
BAKER COUNTY SURVEYOR  
SURVEY NO. 7-44-58