


LEGEND

- FOUND CORNER. BRASS CAP OF RECORD
- ▲ ALUMINUM CAP SET BY P.L.S. # 1664 IN 1982 & 1983
- CORNER SET FROM ORIGINAL G.L.O. EVIDENCE BRASS CAP
- ◆ BRASS OR ALUMINUM CAP CORNERS SET BY SURVEY
- POSTED U.S.F.S. BOUNDARY
- () RECORD G.L.O. BEARING & DISTANCE
- [] METERS
- SURVEY OF RECORD BEARING & DISTANCE

SECTIONS 27, 28, 32, 33 & 34

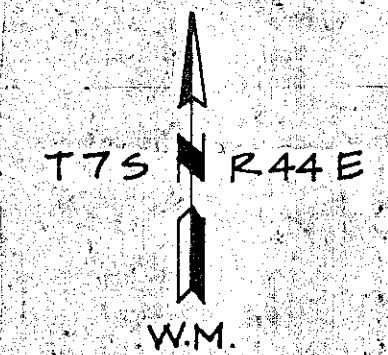

BASIS OF BEARING
SOLAR OBSERVATION

MEAN MAGNETIC DECLINATION
N 20° 00' E

REFERENCE MATERIAL

ORIGINAL G.L.O. NOTES AND PLAT, FIELD BOOKS 1-24.
SURVEYS OF RECORD NUMBERS, B-44-37, B-44-63 & B-44-64.

NOTES

FORM R6-7100-57 FILED WITH THIS PLAT FOR STANDARD INDEX FILE NUMBERS; R-11, R-13, R-15, T-11, T-13, T-15, U-12, U-13, U-14, V-12, V-13, V-14, V-15, V-17, W-9, W-11, W-12, W-13, W-14, W-15, X-9, X-11, X-12, X-13, X-14, X-15, X-16, X-17, Y-13, Y-14, Y-15 AND Y-16.

NOTE A: SEE SHEET 6/6 FOR BREAKDOWN OF THESE 1/4 OF 1/4s.

NOTE B: CORNER TO SECTIONS 27, 28, 33 & 34, T7S, R44E FALLS BELOW HIGH WATER MARK OF EAGLE CREEK. SET WITNESS CORNER S89°41'28"E, 34.00 FT.

NOTE C: FROM THE SURVEYED POSITION OF CORNER TO SECTIONS 27, 28, 33 & 34 A MARKED STONE BEARS N 22° 26' 01" E, 191.34 FT. BEARING TREES WERE FOUND, BUT THEY DO NOT MATCH THE RECORD CALLS. A RING COUNT INDICATES THEY WERE SCRIBED IN THE 1940s.

NOTE D: FROM THE SURVEYED POSITION FOR THE 1/4 CORNER TO SECTIONS 33 & 34 A MOUND OF STONE BEARS N81°53'59"E, 72.66 FT. TWO BEARING TREES ARE NOT THE TREES OF RECORD.

NOTE E: SE 1/16 SEC. 34 FALLS ON ROCK OUTCROP. MARKED WITH NAIL, SET R.M. 5.00 FT. NORTH.

SURVEY HISTORY

TYPED DOCUMENT FILED WITH PLATS.

CANCELLED SEE # 7-44-227

NARRATIVE

TYPED 2 PAGE DOCUMENT FILED WITH PLATS.

I, BARRY B. BARBOUR, a registered land surveyor in the State of Oregon, hereby certify that this plat and notes hereon, or attached are a correct representation of a survey I performed during 1982 to 1985, for the U.S. Forest Service in accordance with the articles of the contract and with the Statutes of the State of Oregon. Contract number 53-04M3-2-2781


Barry B. Barbour

Barry B. Barbour
Registered Land Surveyor
Oregon License 1051

REGISTERED PROFESSIONAL LAND SURVEYOR

OREGON
OCT. 17, 1975
BARRY B. BARBOUR
1051

FILED 7-7-85
BAKER COUNTY SURVEYOR
SURVEY NO. 7-44-75

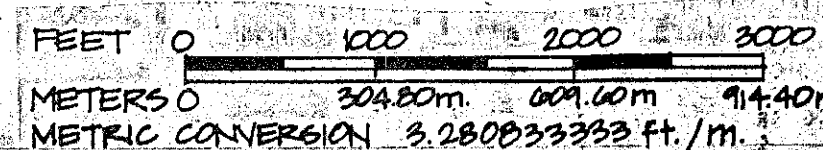

| | |
|---|---|
| SECTIONS 27, 28, 32, 33 & 34 T7S, R44E, W.M. BAKER COUNTY, OREGON U.S.F.S. WALLOWA-WHITMAN NATIONAL FOREST | |
| Scale: 1" = 1000' 1" = 304.80m | Sheet No. 3 |
| Date: APRIL 1985 | BARRY B. BARBOUR Professional Land Surveyor P.O. Box 4811 BOISE, IDAHO |