


CERTIFIED RECORD OF LAND CORNER MONUMENTATION

Index File Number C-21

History of original corner establishment:

Corner was originally established under G. L. O. contact number 503, by W. B. Barr, on August 2, 1884. Surveyor General's notes state: "Set post 4 ft. long 4 ins. diam. 24 inches in ground for 1/4 sec. cor. marked 1/4 S on the W. side. From which a pine 15 ins. diam. bears N10°W, 62 lks. dist. marked 1/4S BT. A pine 10 ins. diam. bears N12°E, 70 lks. dist. marked 1/4S BT."

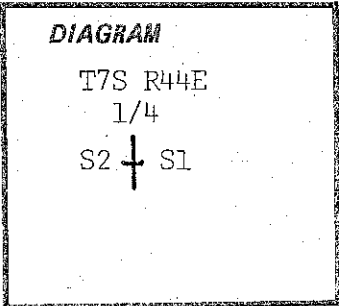

In 1974 the BLM remonumented this corner. Official notes state: "At the corner point, Set an iron post, 28 ins. long, 2 1/2 ins. diam., 24 ins. in the ground, with brass cap mkd. from which new bearing trees: A white fir, 12 ins. diam., bears N16°E, 59 lks. dist., mkd. 1/4 S1 BT. A white fir, 6 ins. diam., bears N55°W, 140 lks. dist. mkd. 1/4 S2 BT." 1974

Description of corner evidence found:

Found 1974 BLM cap and galvanized pipe, leaning against original G. L. O. bearing tree. Found 15" Fir, scribed 1/4 S1 BT. Measured S16°W, 39.9 ft. From here an 8" Fir bears N55°W, 92.7 ft. scribed 1/4 S2 BT. Original G. L. O. bearing tree is N12°W, 26.3 ft.

Description of monument and accessories established to perpetuate the original location of this corner:

At measured point, reset BLM cap and galvanized pipe. Cap is now marked: Set pipe 24" in the ground and mound of stone around to cap. Painted blazes red and 6" red band around. Bearing trees have 54-3s and 54-4s. Placed 54-4 on a steel fence post 5' north of the corner.

T7S R44E
RESET 1/4
OR PLS S2 + S1
1051 1974
1982

I hereby certify that the above corner monument was reestablished as herein described.

Witnesses: Larry D. Shirley
Daniel T. Rowland

July 12, 1982.

REGISTERED PROFESSIONAL LAND SURVEYOR

Barry B. Barbour
OREGON
OCT. 17, 1975
BARRY B. BARBOUR
1051

Office of.....County Surveyor..... County of...Baker.....
State of.....Oregon....., I hereby certify that the within instrument was filed in this office
for record on the..... day of....., 19.85

..... by
(COUNTY OFFICIAL) (DEPUTY)

FILED 11-7-85
BAKER COUNTY SURVEYOR
SURVEY NO. 7-44-80