


CERTIFIED RECORD OF LAND CORNER MONUMENTATION

Index File Number E-2

History of original corner establishment:

Not Set.

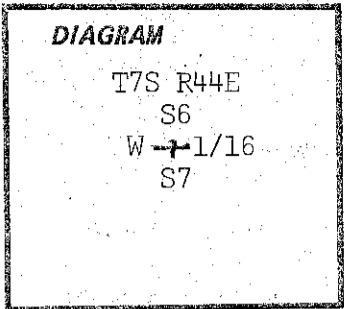

Description of corner evidence found:

None Found.

Description of monument and accessories established to perpetuate the original location of this corner:

At surveyed point set 2 1/2" X 30" galvanized pipe and brass cap marked:  
Set pipe 24" in the ground and mound of stone around to cap.

T7S R44E  
 S6  
 W  $\rightarrow$  1/16  
 S7  
 OR PLS 1051  
 1982

From which by magnetic declination of N20°E:  
An 8" Fir bears S12°E, 11.8 ft. scribed W1/16 S7 BT.  
A 9" Fir bears N10°W, 34.1 ft. scribed W1/16 S6 BT. Painted blazes red and 6" red band around. Placed 54-3s, 54-9s and brass washers stamped PLS 1051 on the bearing trees. Placed 54-2 and 54-9 on a steel fence post 5' east and placed 54-2 on a steel fence post 5' south of the corner.

I hereby certify that the above corner monument was established as herein described.

Witnesses: Larry D. Shirley  
 Michael L. Cain

October 18, 1982.

REGISTERED  
 PROFESSIONAL  
 LAND SURVEYOR

*Barry B. Barbour*

OREGON  
 OCT. 17, 1975  
 BARRY B. BARBOUR  
 1051

Office of.....County Surveyor.....County of.....Baker.....  
 Oregon  
 State of....., I hereby certify that the within instrument was filed in this office  
 for record on the..... day of....., 19.85

..... by .....  
 (COUNTY OFFICIAL) (DEPUTY)

FILED 11-7-85  
 BAKER COUNTY SURVEYOR  
 SURVEY NO. 7-44-81