


CERTIFIED RECORD OF LAND CORNER MONUMENTATION

Index File Number F-4

History of original corner establishment:

Not Set.

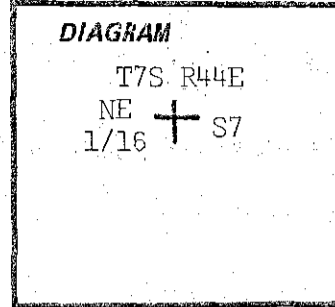

Description of corner evidence found:

None Found.

Description of monument and accessories established to perpetuate the original location of this corner:

At surveyed point set 2 1/2" X 30" galvanized pipe and brass cap marked:  
Set pipe 25" in the ground and mound of stone around to cap.

T7S R44E  
NE + S7  
1/16  
OR PLS 1051  
1982

From which by magnetic declination of N20°E:  
A 9" Pine bears N84°E, 22.5 ft. scribed NE 1/16 S7 BT. A 9" Pine bears N62°W, 45.0 ft. scribed NE 1/16 S7 BT. Painted blazes red and 6" red band around. Placed 54-3s, 54-9s and brass washers stamped PLS 1051 on the bearing trees. Placed 54-2 and 54-9 on a steel fence post 5' south and placed 54-2 on a steel fence post 5' west of the corner.

I hereby certify that the above corner monument was established as herein described.

Witnesses: Larry D. Shirley  
Michael L. Cain

October 21, 1982,

REGISTERED  
PROFESSIONAL  
LAND SURVEYOR

*Barry B. Barbour*

OREGON  
OCT. 17, 1975  
BARRY B. BARBOUR  
1051

Office of.....County Surveyor..... County of.....Baker.....

State of.....Oregon....., I hereby certify that the within instrument was filed in this office for record on the..... day of....., 19.85

(COUNTY OFFICIAL)

(DEPUTY)

Form R6-7100-57 (9/71)

☆ U.S. GOVERNMENT PRINTING OFFICE • 1983-793-276

FILED 11-7-85

BAKER COUNTY SURVEYOR

SURVEY NO. 7-44-84