


CERTIFIED RECORD OF LAND CORNER MONUMENTATION

Index File Number G-2

History of original corner establishment:

Not Set.

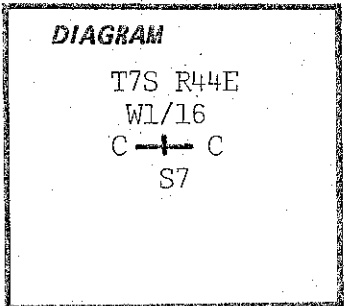

Description of corner evidence found:

None found.

Description of monument and accessories established to perpetuate the original location of this corner:

At surveyed point set 2 1/2" X 30" galvanized pipe and brass cap marked:
Set pipe 25" in the ground and mound of stone around to cap.

From which by magnetic declination of N20°E:
A 25" Pine bears N82°W, 93.3 ft. scribed CW 1/16 S7 BT.
A 14" Pine bears N15°E, 79.3 ft. scribed CW 1/16 S7 BT. Painted blazes red and 6" red band around. Placed 54-3s, 54-9s and brass washers stamped PLS 1051 on the bearing trees. Placed 54-2 and 54-9 on a steel fence post 5' north and placed 54-2 on a steel fence post 5' east of the corner.

T7S R44E
W1/16
C —+— C
S7
OR PLS 1051
1982

I hereby certify that the above corner monument was established as herein described.

Witnesses: Larry D. Shirley
Michael L. Cain

October 15, 1982.

REGISTERED
PROFESSIONAL
LAND SURVEYOR

Barry B. Barbour

OREGON
OCT. 17, 1975
BARRY B. BARBOUR
1051

Office of.....County Surveyor..... County of.....
Oregon
State of....., I hereby certify that the within instrument was filed in this office
for record on the..... day of....., 19.85

..... by
(COUNTY OFFICIAL) (DEPUTY)

FILED 11-7-85
BAKER COUNTY SURVEYOR
SURVEY NO. 7-44-85