


CERTIFIED RECORD OF LAND CORNER MONUMENTATION

Index File Number T-19

History of original corner establishment:

Not Set.

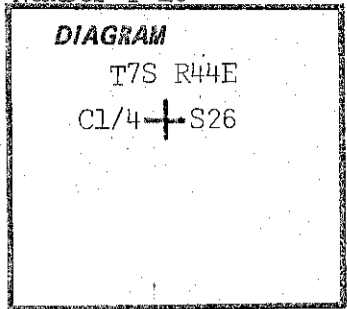

Description of corner evidence found:

None Found.

Description of monument and accessories I established to perpetuate the original location of this corner:

At surveyed point set 2 1/2" X 30" aluminum pipe and cap marked:
Set pipe 20" in the ground and mound of stone around to cap.

T7S R44E
C1/4 + S26
OR PLS 1051
1984

From which by magnetic declination of N20°E:
A 14" Pine bears N85°E, 19.0 ft. scribed C1/4 S26 BT. An 11" Pine bears S65°W, 21.6 ft. scribed C1/4 S26 BT. Painted blazes red and 6" red band around. Placed 54-3s, 54-9s and brass washers stamped PLS 1051 on the bearing trees. Placed 54-9 on a steel fence post 5' west of the corner.

I hereby certify that the above corner monument was established as herein described.

Witnesses: Michael E. Marks
Robert W. Wilson

November 9, 1984.

Office of..... County Surveyor..... County of..... Baker.....
State of..... Oregon....., I hereby certify that the within instrument was filed in this office
for record on the..... day of....., 19.85
..... by
(COUNTY OFFICIAL) (DEPUTY)

FILED 11-7-85
BAKER COUNTY SURVEYOR
SURVEY NO. 7-44-850