


CERTIFIED RECORD OF LAND CORNER MONUMENTATION

Index File Number G-5

History of original corner establishment:

Corner was originally established under G. L. O. contract number 503, by W. B. Barn, on August 19, 1884. Surveyor General's notes state: "Set sandstone 24 X 10 X 10 ins. 18 inches in ground for 1/4 sec. cor. marked 1/4 on the W. side. From which a fir 15 ins. diam. bears S65 1/2°W, 28 lks. dist. marked 1/4S BT. A fir 3 ins. diam. bears N34°W, 13 lks. dist. marked 1/4S BT."

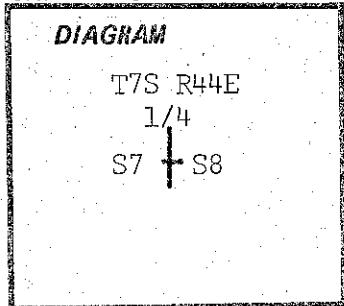

Description of corner evidence found:

Found no trace of record stone or bearing trees. During survey of area, found old, but not G. L. O. blaze lines south and west of the corner area. Corner has been disturbed by the road building and logging, and falls on steep east slope.

Description of monument and accessories established to perpetuate the original location of this corner:

At surveyed point set 2 1/2" X 30" galvanized pipe and brass cap marked:
Set pipe 24" in the ground and mound of stone around to cap.
From which by magnetic declination of N20°E:
A 9" Fir bears N60°E, 13.3 ft. scribed 1/4 S8 BT. A 9" Fir bears S09°W, 69.5 ft. scribed 1/4 S7 BT. Painted blazes red and 6" red band around. Placed 54-3s, 54-4s and brass washers stamped PLS 1051 on the bearing trees. Placed 54-2 and 54-4 on a steel fence post 5' south and placed 54-2 on a steel fence post 5' west of the corner.

T7S R44E
1/4
S7 + S8
OR PLS 1051
1982

I hereby certify that the above corner monument was reestablished as herein described.

Witnesses: Larry D. Shirley
Michael L. Cain

October 18, 1982.

REGISTERED
PROFESSIONAL
LAND SURVEYOR

Barry B. Barbour
OREGON
OCT. 17, 1975
BARRY B. BARBOUR
1051

Office of.....County Surveyor..... County of.....Baker.....
State of.....Oregon..... I hereby certify that the within instrument was filed in this office
for record on the..... day of....., 19.85

..... by
(COUNTY OFFICIAL) (DEPUTY)

FILED 11-7-85
BAKER COUNTY SURVEYOR
SURVEY NO. 7-44-88